
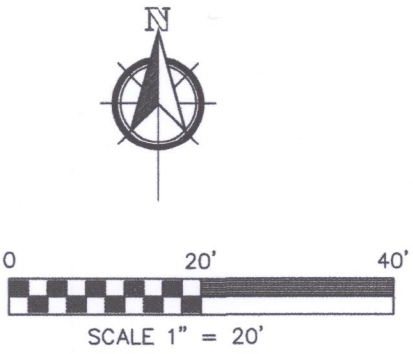


PLAT OF SURVEY

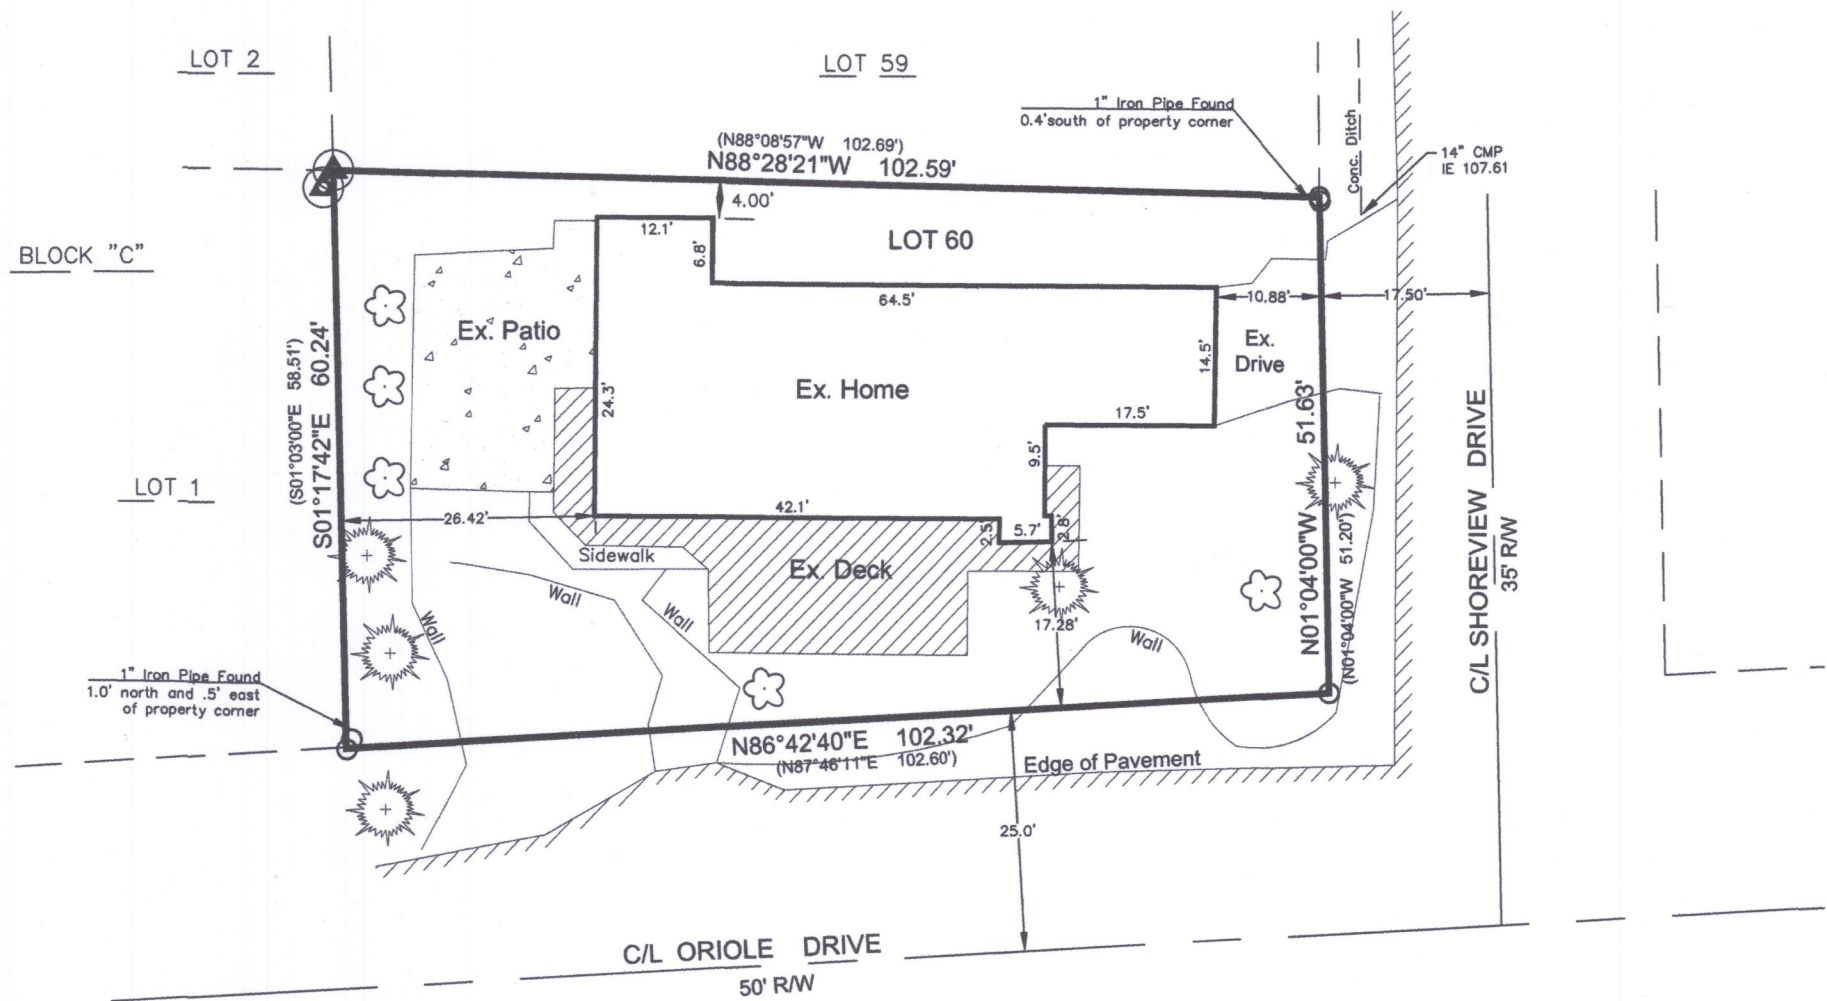

LEGEND

	1" IRON PIPE- FOUND
	CONCRETE MONUMENT-FOUND
	EXISTING CONIFEROUS TREE
	EXISTING DECIDUOUS TREE
	RECORDED AS INFORMATION

Note:
1. Basis of bearing: The West line of Shoreview Drive was taken to bear N01°04'00"W.
2. This property is located within Walworth County Shoreland Jurisdictional limits.

FOR:
CHRISTELL C. JOHNS TRUST
8 HARDWICK CT.
SUGAR GROVE, IL 60554



LEGAL DESCRIPTION:

LOT 60, BLOCK "C", CISCO BEACH, LOCATED IN TOWN 1 NORTH, RANGE 17 EAST, TOWN OF LINN, WALWORTH COUNTY, WISCONSIN.

SURVEYOR'S CERTIFICATE:

I, PAUL H. VAN HENKELUM, #1931, HEREBY CERTIFY THAT THIS SURVEY WAS MADE IN ACCORDANCE WITH THE MINIMUM STANDARDS FOR PROPERTY SURVEYS (CHAPTER A-E7) FOR THE STATE OF WISCONSIN AND HAS BEEN PREPARED UNDER MY DIRECTION AND CONTROL AND IS CORRECT TO THE BEST OF MY KNOWLEDGE AND BELIEF.

PAUL H. VAN HENKELUM, R.L.S. S-1931

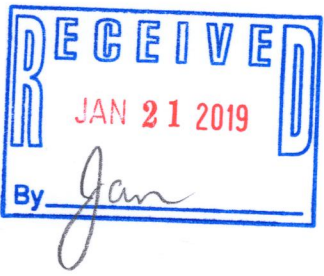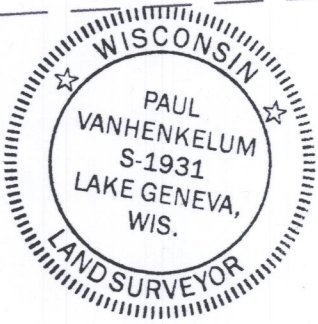



CARDINAL ENGINEERING LLC
DESIGNING IN TRUE DIRECTIONS

201 BROAD STREET, STE. B
LAKE GENEVA, WI 53147
262-757-8776
CARDINALENGINEERINGWI.COM

DATE: 10-09-2018
SHEET 1 OF 1

ICI-74 117-4222