
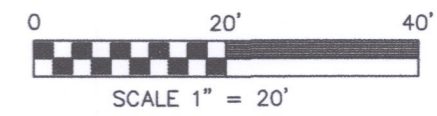



# PLAT OF SURVEY

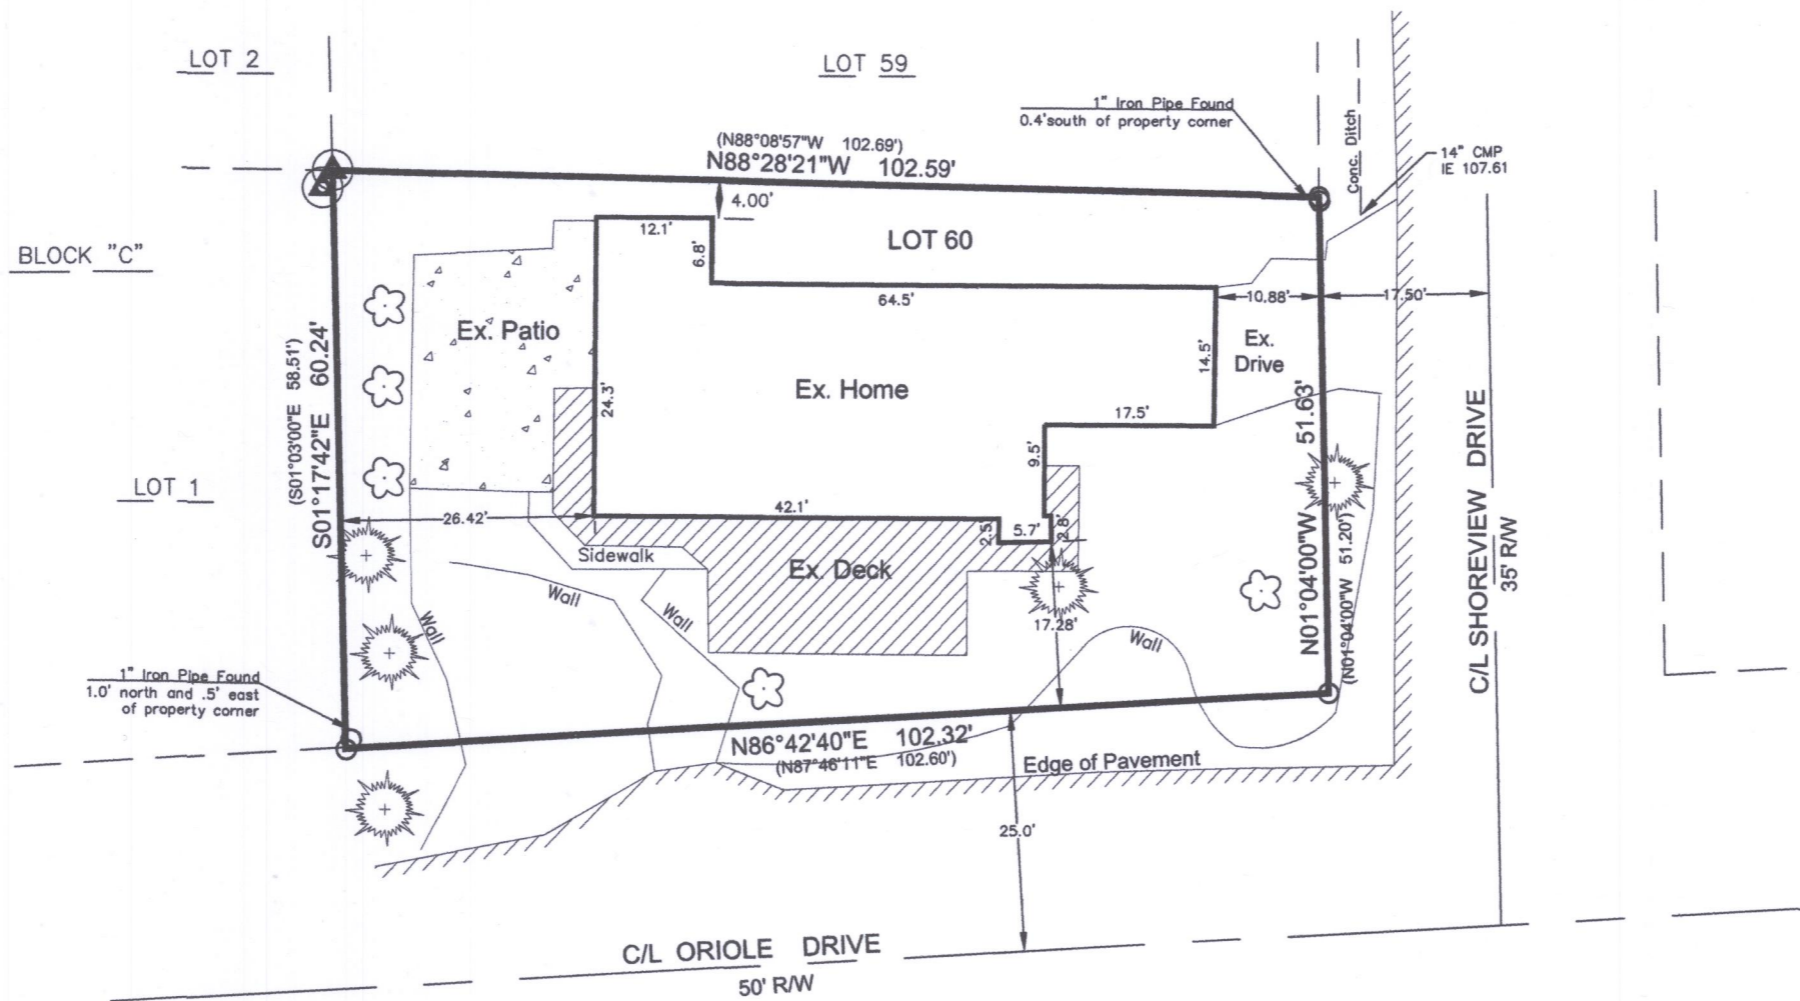

**LEGEND**

	1" IRON PIPE- FOUND
	CONCRETE MONUMENT-FOUND
	EXISTING CONIFEROUS TREE
	EXISTING DECIDUOUS TREE
	RECORDED AS INFORMATION

**Note:**  
 1. Basis of bearing: The West line of Shoreview Drive was taken to bear N01°04'00"W.  
 2. This property is located within Walworth County Shoreland Jurisdictional limits.

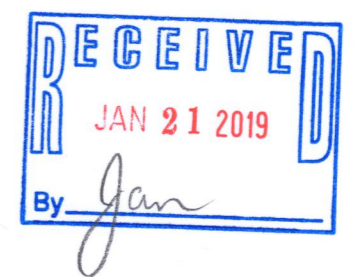

FOR:  
 CHRISTELL C. JOHNS TRUST  
 8 HARDWICK CT.  
 SUGAR GROVE, IL 60554

**LEGAL DESCRIPTION:**  
 LOT 60, BLOCK "C", CISCO BEACH, LOCATED IN TOWN 1 NORTH, RANGE 17 EAST, TOWN OF LINN, WALWORTH COUNTY, WISCONSIN.

**SURVEYOR'S CERTIFICATE:**  
 I, PAUL H. VAN HENKELUM, #1931, HEREBY CERTIFY THAT THIS SURVEY WAS MADE IN ACCORDANCE WITH THE MINIMUM STANDARDS FOR PROPERTY SURVEYS (CHAPTER A-E7) FOR THE STATE OF WISCONSIN AND HAS BEEN PREPARED UNDER MY DIRECTION AND CONTROL AND IS CORRECT TO THE BEST OF MY KNOWLEDGE AND BELIEF.

*Paul H. Van Henkelum*  
 PAUL H. VAN HENKELUM, R.L.S. S-1931



CARDINAL ENGINEERING LLC  
 DESIGNING IN TRUE DIRECTIONS

201 BROAD STREET, STE. B  
 LAKE GENEVA, WI 53147  
 262-757-8776  
 CARDINALENGINEERINGWI.COM

DATE: 10-09-2018  
 SHEET 1 OF 1

ICI-74 117-4222