



-OF-

SURVEY FOR: JOHN LAW OF RE/MAX PLAZA
SURVEY ADDRESS: N2436 SHOREVIEW DRIVE, LAKE GENEVA, WI 53147

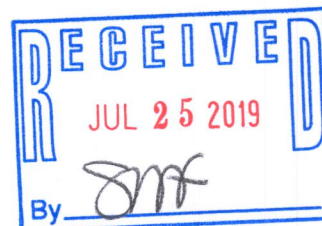

- FOUND IRON PIPE
- FOUND IRON ROD
- () RECORDED AS
- △ UTILITY POLE

BEARINGS HEREON RELATE TO THE NORTH
LINE OF LOT 8 IN BLOCK "1" OF CISCO BEACH
SUBDIVISION. ASSUMED BEARING OF EAST.

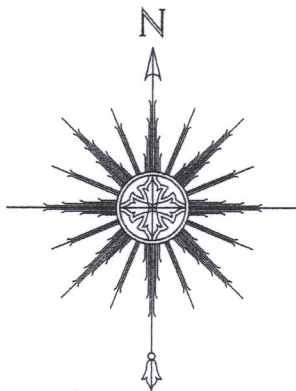

"I HEREBY CERTIFY THAT I HAVE SURVEYED THE ABOVE DESCRIBED PROPERTY AND THAT THE ABOVE MAP IS A CORRECT REPRESENTATION THEREOF AND SHOWS THE SIZE AND LOCATION OF THE PROPERTY, ITS EXTERIOR BOUNDARIES, THE LOCATION OF ALL VISIBLE STRUCTURES AND DIMENSIONS OF ALL PRINCIPAL BUILDINGS THEREON, BOUNDARY FENCES, APPARENT EASEMENTS, ROADWAYS AND ENCROACHMENTS, IF ANY."

"THIS SURVEY IS MADE FOR THE USE OF THE PRESENT OWNERS OF THE PROPERTY, AND THOSE WHO PURCHASE, MORTGAGE, OR GUARANTEE THE TITLE THERETO WITHIN ONE YEAR FROM DATE HEREOF."

SATTER SURVEYING, LLC
LAND SURVEYS, MAPPING AND PLANNING
272 ORIGEN STREET
BURLINGTON, WI 53105
262-661-4239

A circular professional seal for a Wisconsin Land Surveyor. The outer ring contains the text "WISCONSIN" at the top and "LAND SURVEYOR" at the bottom, separated by two five-pointed stars. The inner circle contains the text "THOMAS L. SATTER", "S-2850", and "BURLINGTON, WI" arranged vertically.

THIS IS NOT AN ORIGINAL PRINT
UNLESS THIS SEAL IS RED.

Thomas L. Satter

JUNE 14, 2019
DATE

061901

JOB NUMBER

0 15' 30' 60

SCALE: 1" = 30'