


Scale
1" = 30'

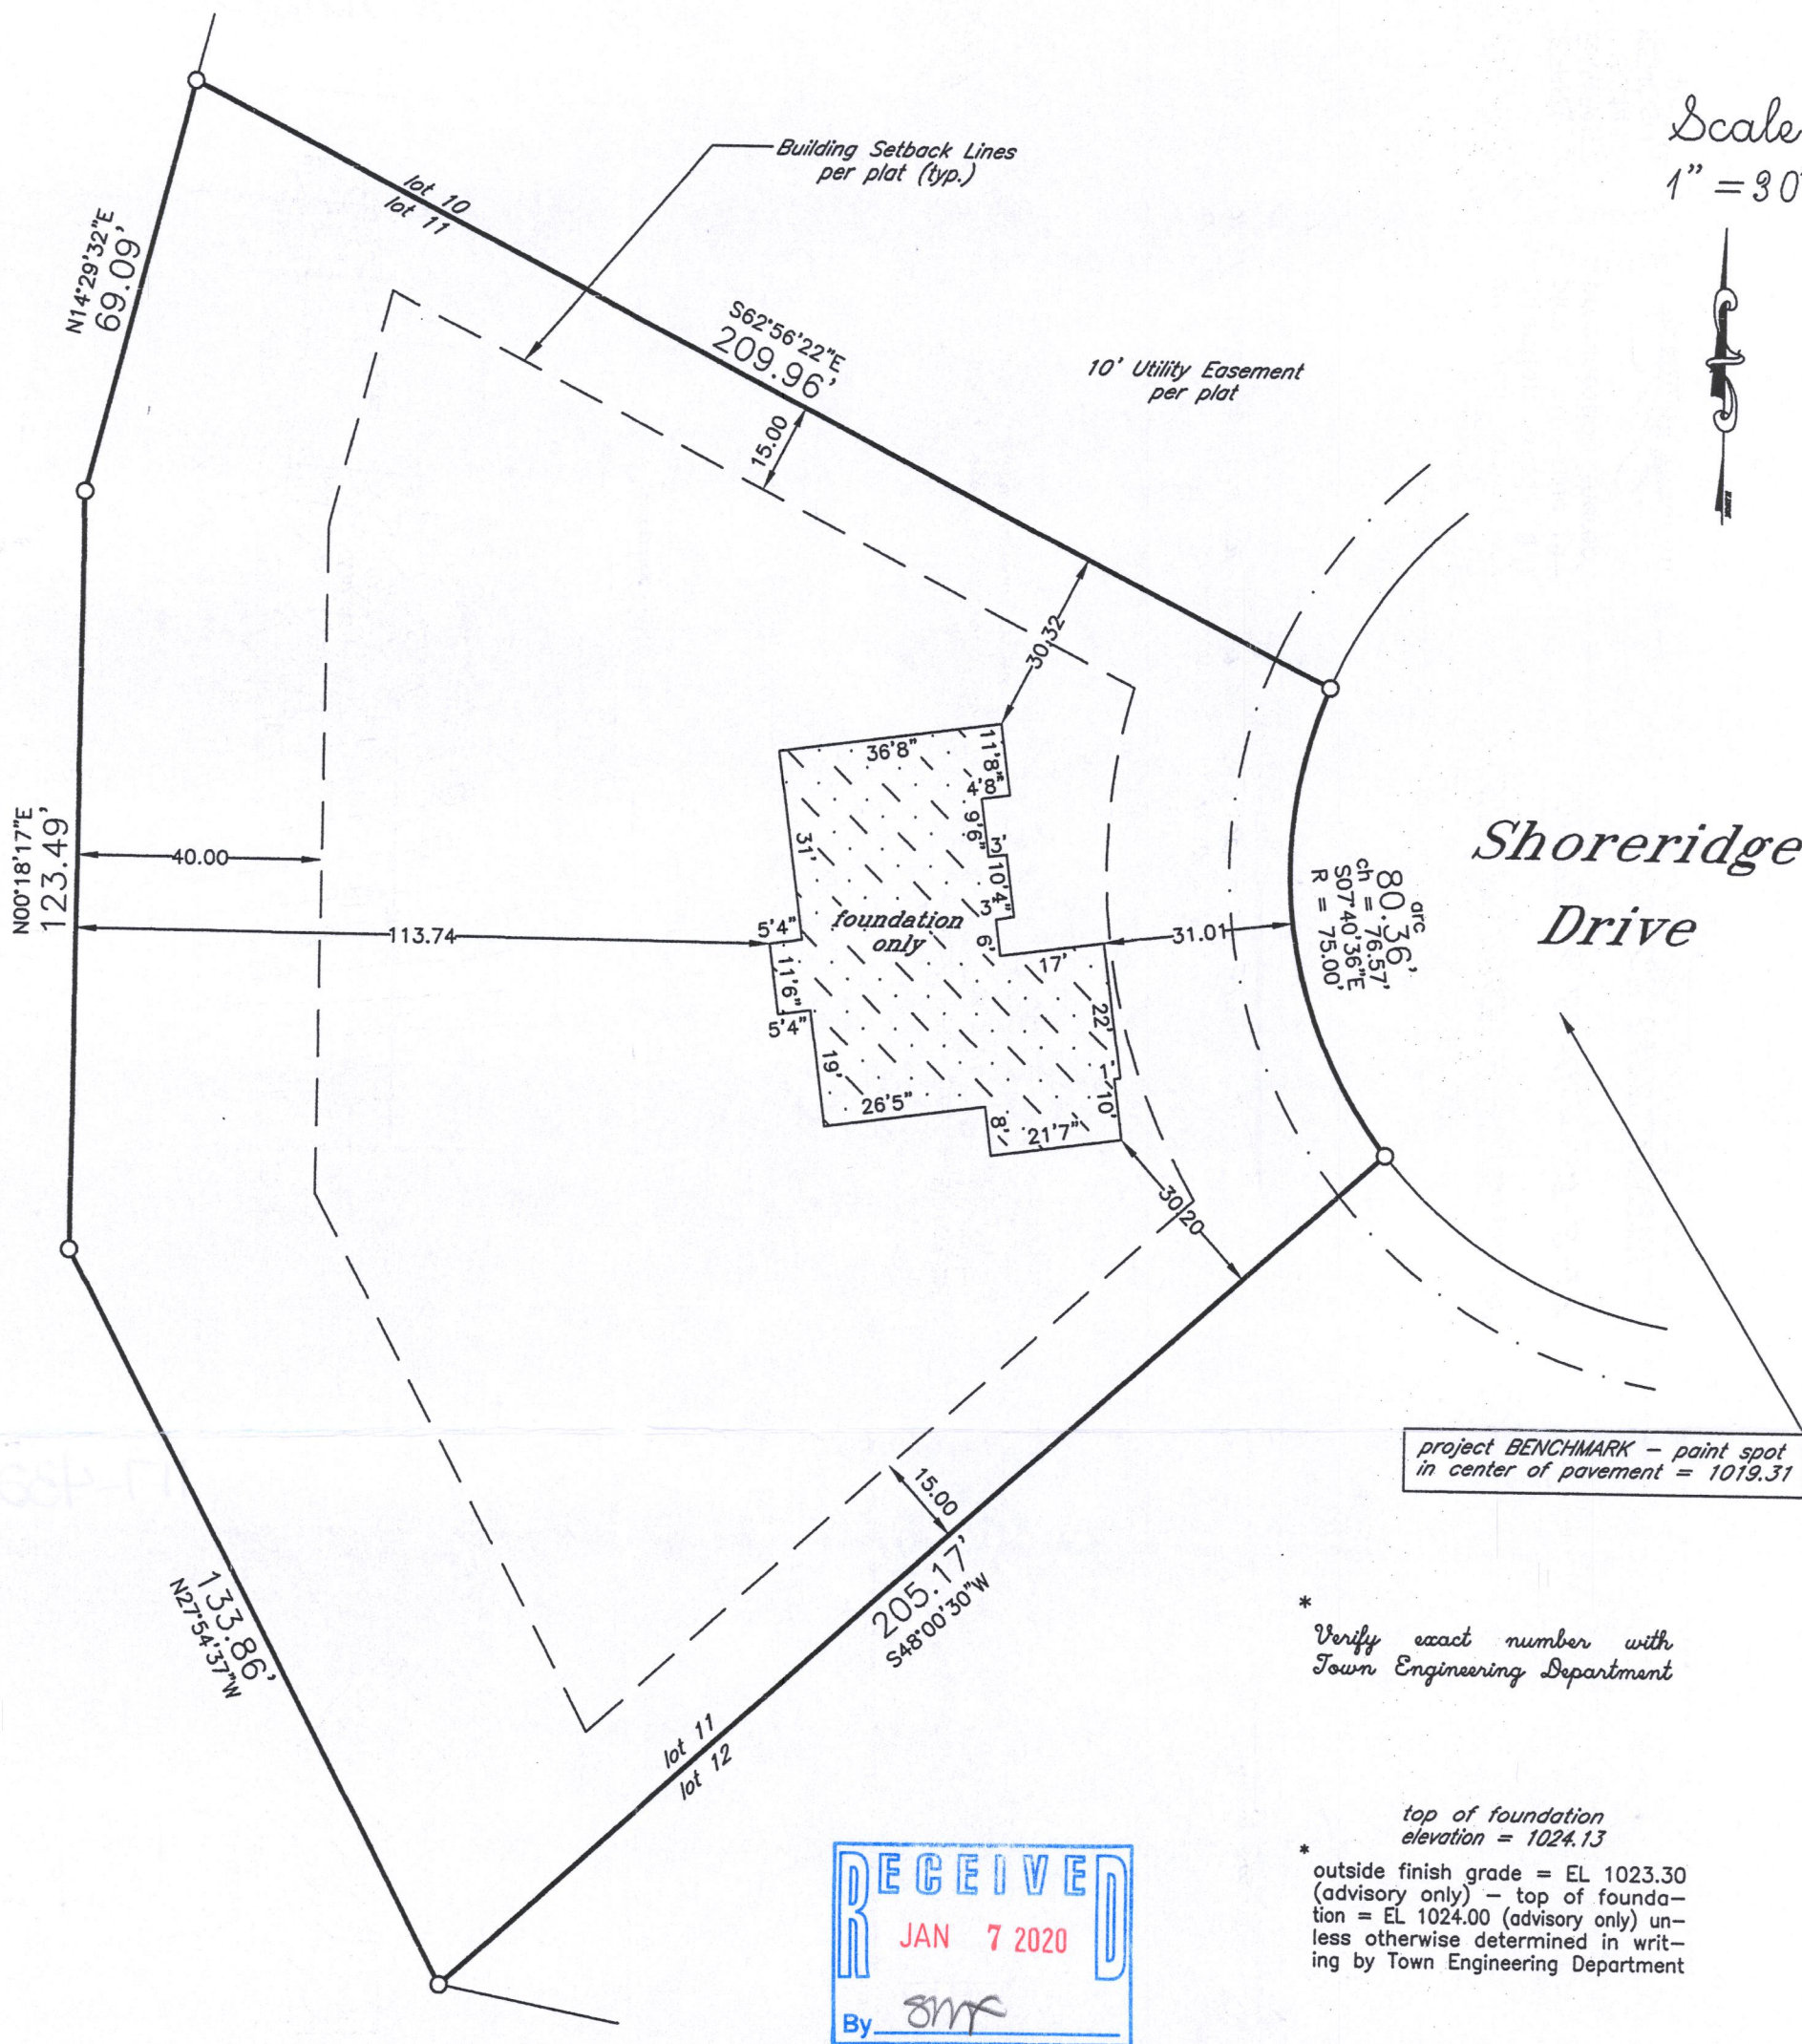

*
Verify exact number with
Town Engineering Department

*
top of foundation
elevation = 1024.13
outside finish grade = EL 1023.30
(advisory only) - top of founda-
tion = EL 1024.00 (advisory only) un-
less otherwise determined in writ-
ing by Town Engineering Department

denotes iron
pipe

Proposed building field staked true size. Contractor to verify all dimensions be-
fore building by same and adhere to drainage plan in effect for this subdivision.
Refer to a current title report for easements or restrictions which may affect
the use of this site that are not shown on the recorded subdivision plat.

J.K.R. SURVEYING, INC.
8121 22ND AVENUE
KENOSHA, WI 53143

I hereby certify that
this property was
surveyed under my
direction and this
plat is a true re-
presentation thereof.

[Signature]

Reg. Land Surveyor
July 11, 2019
Revised 11/14/19


lot area = 40,735 S.F.

*
Verify exact number with
Town Engineering Department

Plat of Survey of
LOT 11 IN
MEADOW VIEW ESTATES
in SE1/4 Section 17-1-17
TOWN OF LINN
WALWORTH COUNTY, WIS.

-for-
Serenity Homes

117-4328

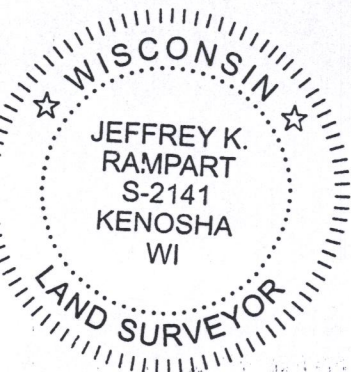

IMEA-11