


LEGEND

●	FOUND 1" IRON PIPE	▬	EXISTING ASPHALT DRIVE
•	FOUND .5" IRON PIPE	▬	EXISTING BUILDING
○	SET 1" IRON PIPE	▨	EXISTING DECK
▲	FOUND MAG NAIL	⊙	SEPTIC LID
⊕	POWER POLE	⊗	WELL
(XX)	RECORDED AS		

PLAT OF SURVEY

A PARCEL OF LAND LOCATED IN THE SOUTHEAST 1/4 OF THE NORTHEAST 1/4 OF SECTION 9 IN TOWNSHIP 1 NORTH, RANGE 17 EAST, IN THE TOWN OF LINN, WALWORTH COUNTY, WISCONSIN.

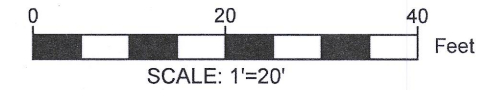


- NOTE:
1. BASIS OF BEARING: THE WISCONSIN STATE PLANE COORDINATE SYSTEM, NAD-83, SOUTH ZONE.
 2. FIELD WORK COMPLETED MAY 26, 2020
 3. BUILDING SURVEYED TO THE EXTERIOR OF SIDING.
- FIELD CREW CHIEF: LOGAN RANDLE

LOT 19
BIRCHES SUBDIVISION

LEGAL DESCRIPTION:

A PARCEL OF LAND LOCATED IN THE SOUTHEAST 1/4 OF THE NORTHEAST 1/4 OF SECTION 9 IN TOWNSHIP 1 NORTH, RANGE 17 EAST, IN THE TOWN OF LINN, WALWORTH COUNTY, WISCONSIN, MORE PARTICULARLY DESCRIBED AS:

LOT 18 OF THE BIRCHES SUBDIVISION ADD. #1 AS RECORDED IN DOCUMENT P257380 IN THE WALWORTH COUNTY REGISTER OF DEEDS.

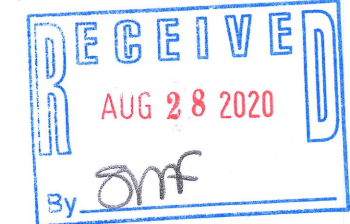

SURVEY ORDERED BY:


RJ AMANN BUILDERS

PROPERTY ADDRESS:

1938 SOLAR LA
LAKE GENEVA, WI 53147


SURVEYOR:

PAUL H. VAN HENKELUM, PLS
CARDINAL ENGINEERING LLC

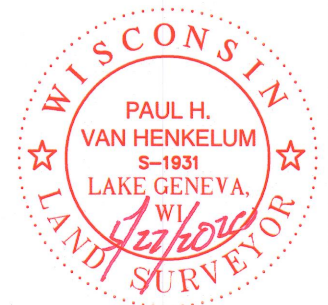

"I HEREBY CERTIFY THAT I HAVE SURVEYED THE ABOVE DESCRIBED PROPERTY AND THE MAP IS A TRUE AND CORRECT REPRESENTATION OF ITS EXTERIOR BOUNDARIES AND SHOWS THE SIZE AND LOCATION OF ALL VISIBLE STRUCTURES, APPARENT EASEMENTS AND ENCROACHMENTS, IF ANY."

Paul H. Van Henkelum *5/27/2020*
 PAUL H VAN HENKELUM, PLS #1931 DATE

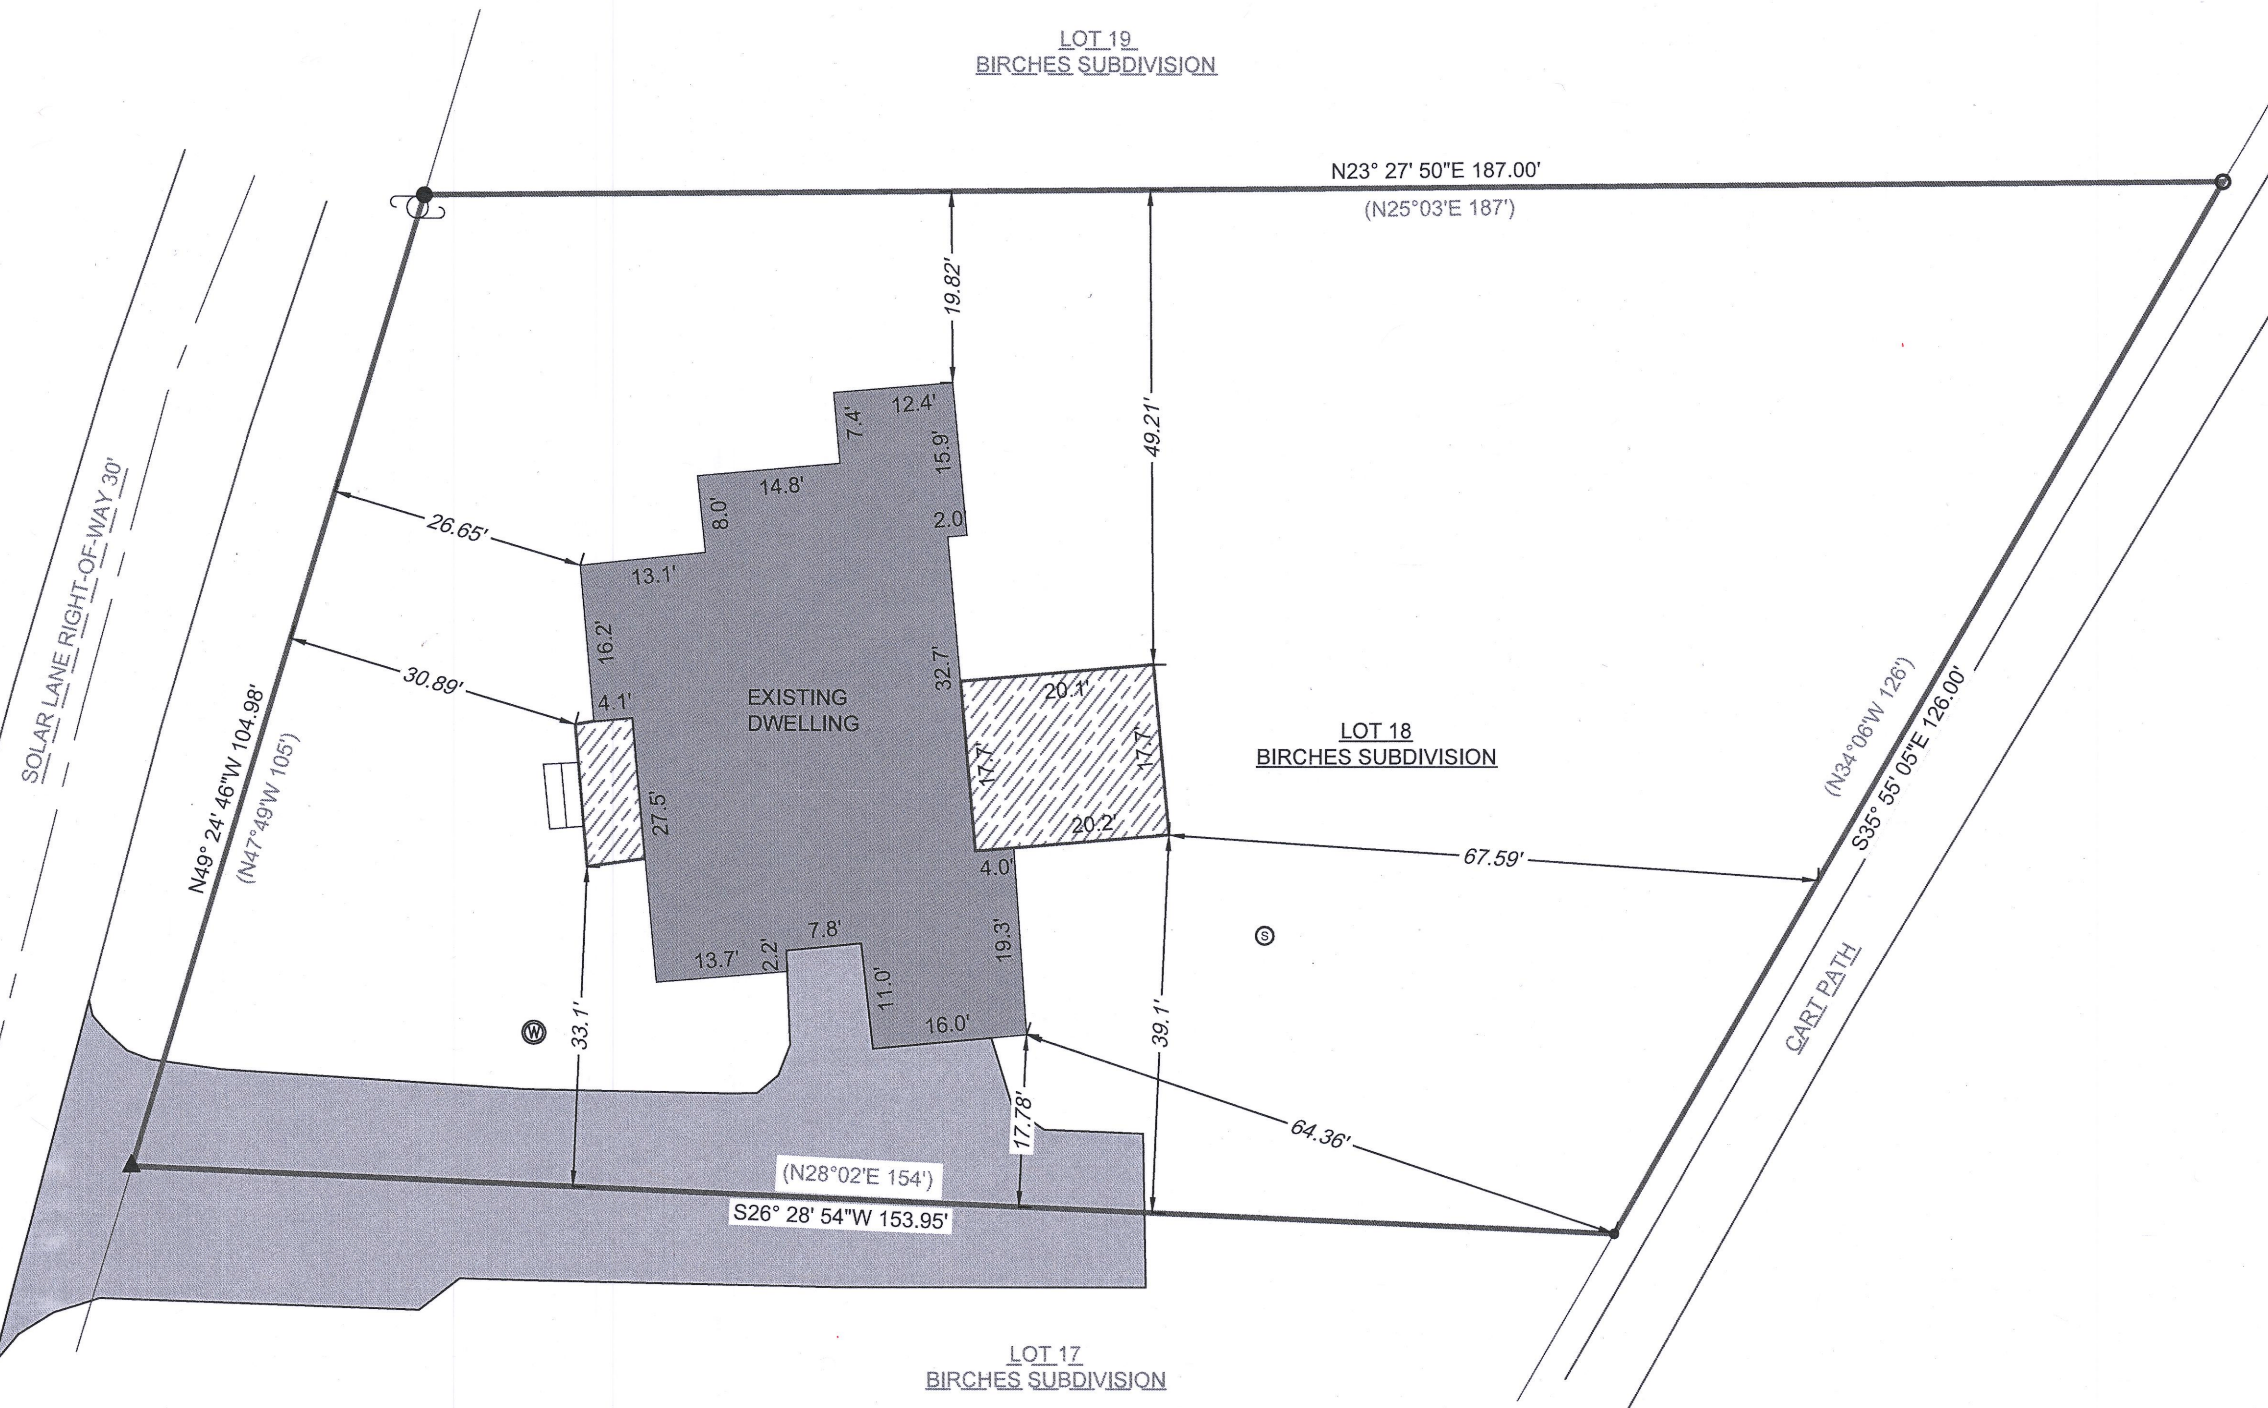

CARDINAL ENGINEERING LLC
DESIGNING IN TRUE DIRECTIONS

PO BOX 281 - 1200 LASALLE ST.
LAKE GENEVA, WI 53147
262-757-8776
CARDINALENGINEERINGWI.COM

DATE: 05-27-2020 JOB No. 20358
SHEET 1 OF 1

IBAI-11A

117-4384