


# PLAT OF SURVEY

A PARCEL OF LAND LOCATED IN THE NORTHEAST 1/4 OF THE SOUTHEAST 1/4 OF SECTION 8 IN TOWNSHIP 1 NORTH, RANGE 17 EAST, IN THE TOWN OF LINN, WALWORTH COUNTY, WISCONSIN.

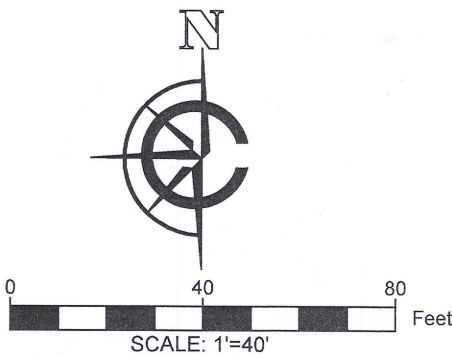

- NOTE:
1. BASIS OF BEARING: THE WISCONSIN STATE PLANE COORDINATE SYSTEM, NAD-83, SOUTH ZONE.
  2. FIELD WORK COMPLETED JULY 31, 2020
  3. BUILDING SURVEYED TO THE EXTERIOR OF SIDING.
  4. FIELD CREW CHIEF: LOGAN RANDLE


## LEGEND

●	FOUND 1" IRON PIPE
○	SET 1" IRON PIPE
( XX )	RECORDED AS
	EXISTING BUILDING
	EXISTING DECK
	EXISTING GRAVEL
	EXISTING CONCRETE
	POWER POLE
	WELL
	SANITARY LID
	FENCE

## LEGAL DESCRIPTION:

A PARCEL OF LAND LOCATED IN THE NORTHEAST 1/4 OF THE SOUTHEAST 1/4 OF SECTION 8 IN TOWNSHIP 1 NORTH, RANGE 17 EAST, IN THE TOWN OF LINN, WALWORTH COUNTY, WISCONSIN, MORE PARTICULARLY DESCRIBED AS:

LOT 2 OF CERTIFIED SURVEY MAP NO. 1547 AS RECORDED IN VOLUME 7 OF CERTIFIED SURVEY MAPS, PAGE 175, AS PER THE WALWORTH COUNTY REGISTER OF DEEDS.

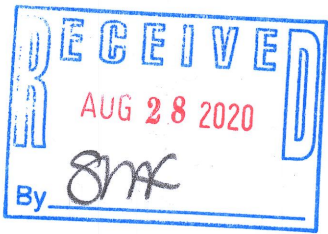

## SURVEY ORDERED BY:


LAURIE WALSH

## PROPERTY ADDRESS:

N1850 OAKLAND ROAD  
LAKE GENEVA, WI 53147

## SURVEYOR:

PAUL H. VAN HENKELUM, PLS  
CARDINAL ENGINEERING LLC

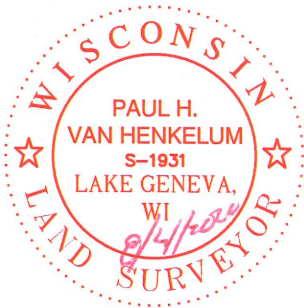

"I HEREBY CERTIFY THAT I HAVE SURVEYED THE ABOVE DESCRIBED PROPERTY AND THE MAP IS A TRUE AND CORRECT REPRESENTATION OF ITS EXTERIOR BOUNDARIES AND SHOWS THE SIZE AND LOCATION OF ALL VISIBLE STRUCTURES, APPARENT EASEMENTS AND ENCROACHMENTS, IF ANY."

PAUL H VAN HENKELUM, PLS #1931

DATE

8/4/2020



CARDINAL ENGINEERING LLC  
DESIGNING IN TRUE DIRECTIONS

PO BOX 281 - 1200 LA SALLE ST.  
LAKE GENEVA, WI 53147  
262-757-8776  
CARDINALENGINEERINGWI.COM

DATE: 08/04/2020 JOB No. 20411  
SHEET 1 OF 1

