






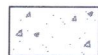


LEGEND

- FOUND 1" IRON PIPE
-  EXISTING CONCRETE
-  EXISTING BUILDING
-  PROPOSED RESIDENCE
-  PROPOSED DRIVEWAY
- ( XX ) RECORDED AS
-  UTILITY PEDESTAL
-  TELEPHONE POLE
-  WELL HEAD

# AS BUILT

A PARCEL OF LAND LOCATED IN THE NORTHEAST 1/4 OF THE NORTHEAST 1/4 OF SECTION 16 IN TOWNSHIP 1 NORTH, RANGE 17 EAST, IN THE TOWN OF LINN, WALWORTH COUNTY, WISCONSIN.

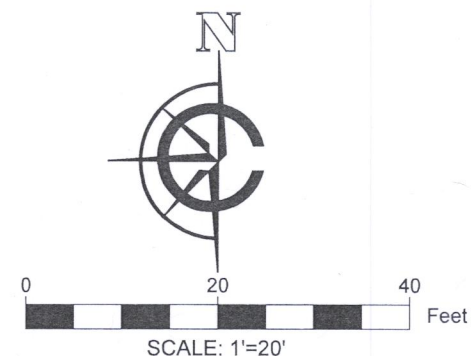


- NOTE:
1. BASIS OF BEARING: THE WISCONSIN STATE PLANE COORDINATE SYSTEM, NAD-83, SOUTH ZONE.
  2. FIELD WORK COMPLETED OCTOBER 8TH, 2019
  3. BUILDING SURVEYED TO THE EXTERIOR OF SIDING.

LEGAL DESCRIPTION:

A PARCEL OF LAND LOCATED IN THE NORTHEAST 1/4 OF THE NORTHEAST 1/4 OF SECTION 16 IN TOWNSHIP 1 NORTH, RANGE 17 EAST, IN THE TOWN OF LINN, WALWORTH COUNTY, WISCONSIN, MORE PARTICULARLY DESCRIBED AS:

LOT 8 OF BLOCK 6 OF LAKEVIEW PARK SUBDIVISION, AS RECORDED AS DOCUMENT P272807 IN THE WALWORTH COUNTY REGISTER OF DEEDS

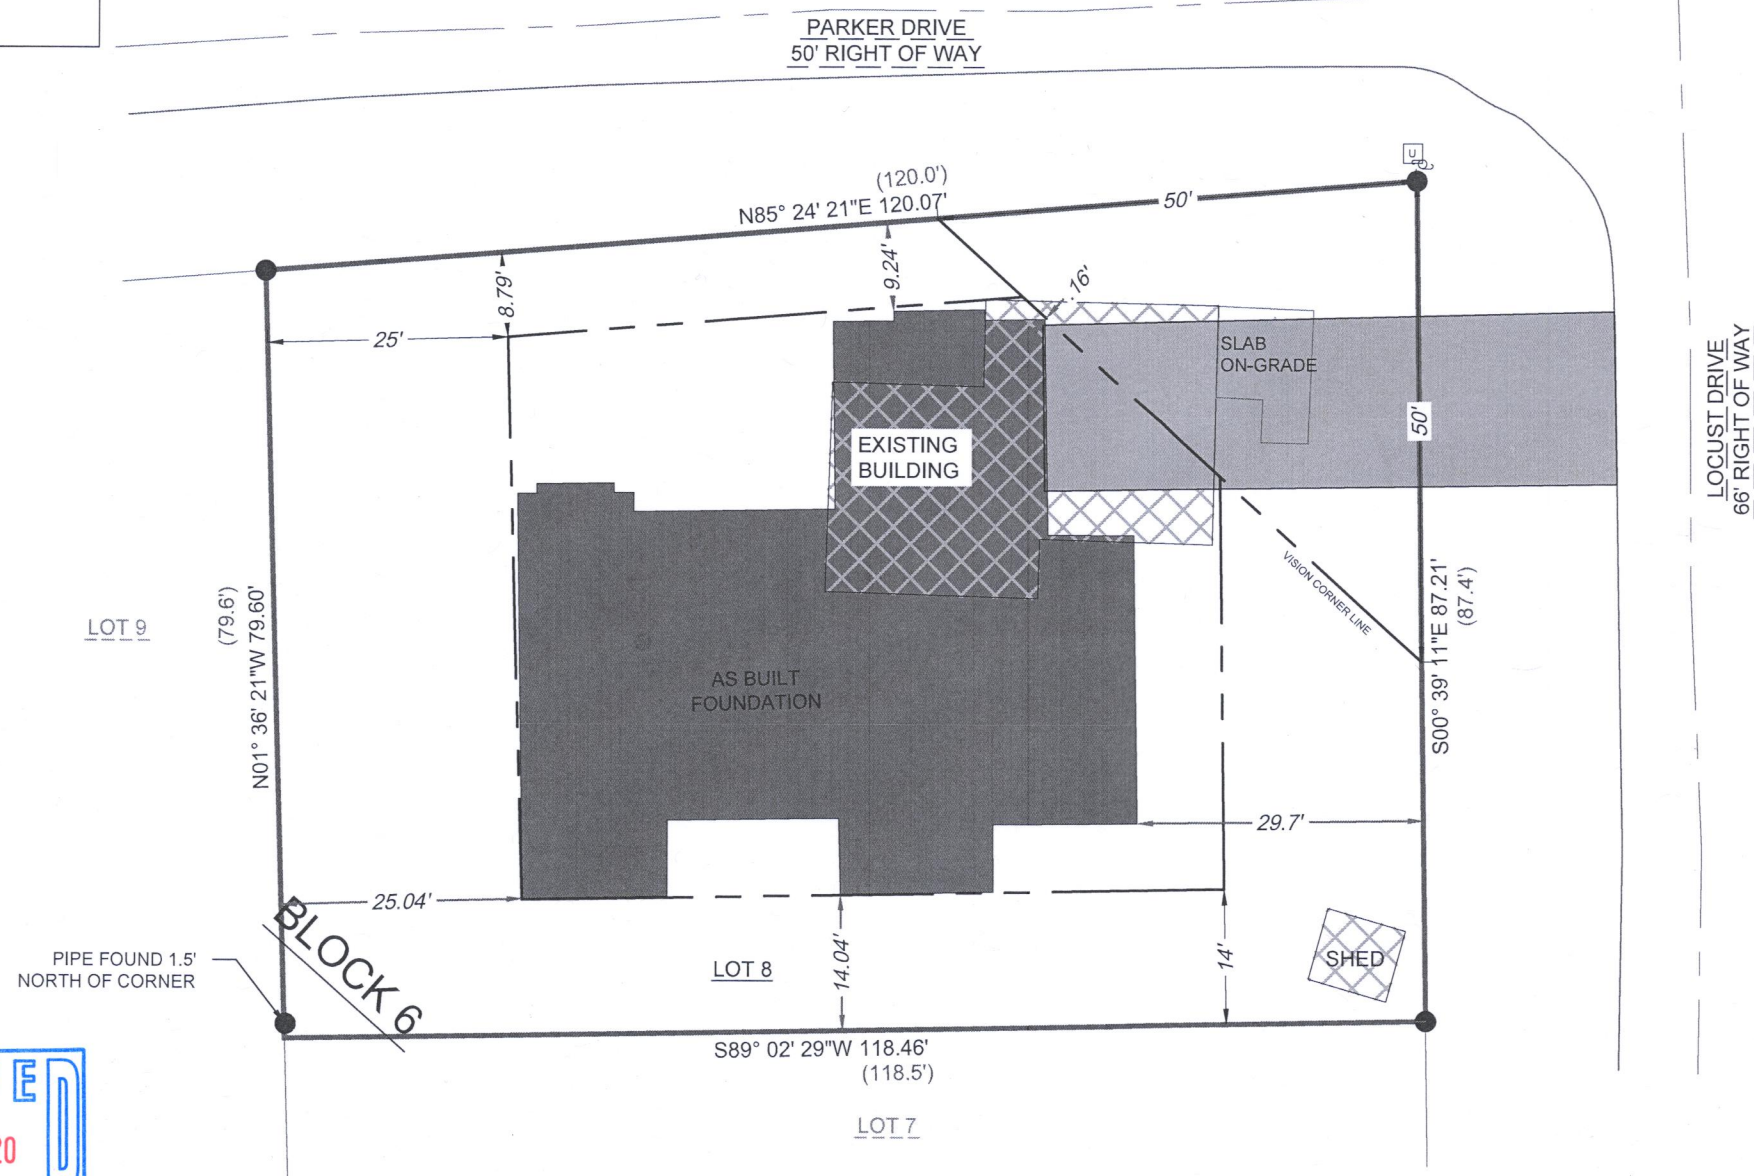

SURVEY ORDERED BY:  
BALSITIS CONTRACTING


PROPERTY ADDRESS:  
N1657 LOCUST DRIVE  
LAKE GENEVA, WI 53147


SURVEYOR:

PAUL H. VAN HENKELUM, PLS  
CARDINAL ENGINEERING LLC

"I HEREBY CERTIFY THAT I HAVE SURVEYED THE ABOVE DESCRIBED PROPERTY AND THE MAP IS A TRUE AND CORRECT REPRESENTATION OF ITS EXTERIOR BOUNDARIES AND SHOWS THE SIZE AND LOCATION OF ALL VISIBLE STRUCTURES, APPARENT EASEMENTS AND ENCROACHMENTS, IF ANY."

*Paul H. Van Henkelum*  
PAUL H. VAN HENKELUM, PLS #1931

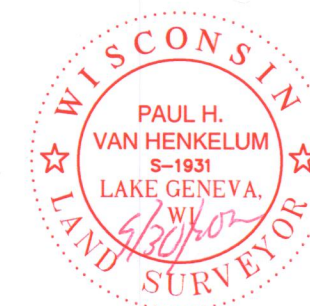

 CARDINAL ENGINEERING LLC  
DESIGNING IN TRUE DIRECTIONS  
PO BOX 283 - 1200 LASALLE ST.  
LAKE GENEVA, WI 53147  
262-757-8776  
CARDINALENGINEERINGWI.COM

DATE: 09-28-2020 JOB No. 20333  
SHEET 1 OF 1

ILVP-29

117-4397