

—OF—

49.85'
50')

First floor
elev. = 98.5'

EXISTING DWELLING

N00°22'11"E
(NORTH

on deck

(SOUTH
00°18'21"W

holding
tank
○ Top of tank
97.35

(EAST
N89°50'38"E

60')
59.75'

5' WIDE) ——— *LANE* ———

(15' WIDE)

40')
39.89'

(NORTH
N00°22'11"E

SYBIL

septic
tank



Top of tank
100.0

EXISTING FOUNDATION

Top of foundation = 100.5'

S89°52'30"W
(WEST)

59.98'
(60')

100.0

Top of porch
elev. = 105.6'

101.1

LOT 29

101.3

7.95'

EXISTING DWELLING

EXISTING DWELLING

o	FOUND IRON PIPE
⚔	FOUND IRON ROD
●	FOUND MASONRY NAIL
⚡	FOUND "MAG SPIKE"
()	RECORDED AS
100.0	EXISTING ELEVATION

BEARINGS HEREON RELATE TO THE NORTH LINE OF THE SURVEYED PROPERTY. ASSUMED BEARING OF N89°50'38"E TO ORIENTATE WITH A PREVIOUS SURVEY OF RECORD OF THE ADJACENT PROPERTY TO THE NORTH.

"I HEREBY CERTIFY THAT I HAVE SURVEYED THE ABOVE DESCRIBED PROPERTY AND THAT THE ABOVE MAP IS A CORRECT REPRESENTATION THEREOF AND SHOWS MAP IS A LOCATION OF THE PROPERTY, ITS EXTERIOR BOUNDARIES, THE LOCATION OF ALL VISIBLE STRUCTURES AND DIMENSIONS OF ALL PRINCIPAL BUILDINGS THEREON, BOUNDARY FENCES, APPARENT EASEMENTS, ROADWAYS AND ENCROACHMENTS, IF ANY."

"THIS SURVEY IS MADE FOR THE USE OF THE PRESENT OWNERS OF THE PROPERTY, AND THOSE WHO PURCHASE, MORTGAGE, OR GUARANTEE THE TITLE THERETO WITHIN ONE YEAR FROM DATE HEREOF."

THIS IS NOT AN ORIGINAL PRINT
UNLESS THIS SEAL IS RED.

UNLESS THIS SEAL IS RED.

THOMAS L. SATTER


S-2850

CASTED CITIZENSHIP IN

LAND SURVEYS, MAPPING AND PLANNING

272 ORIGIN STREET
BURLINGTON, WI 53105

262-661-4239

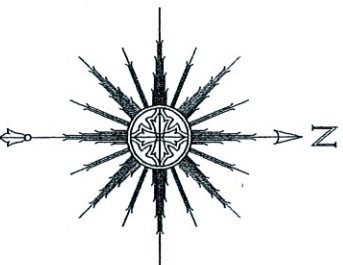

SCALE: 1" = 10'

REVISSED: 11/24/20
REVISSED: 7/2/20
REVISSED: 2/22/20
NOVEMBER 25, 2019
DATE

DATE _____

111905
JOB NUMBER