


Plat of Survey

of



Lot 2 of Oak Shores,

a subdivision located in Government Lot 3 in the Northwest 1/4 of Section 18,
Town 1 North, Range 17 East, Town of Linn, Walworth County, Wisconsin.

Surveyed for: **Ellen Vogel**
N1580 Oak Shores Lane
Fontana, Wisconsin. 53125

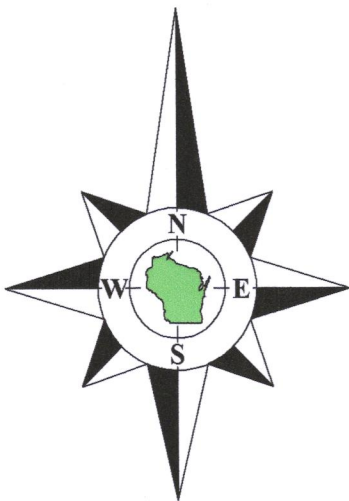

Bearings referenced to the West line of Lot 2,
recorded as North on the plat of Oak Shores.

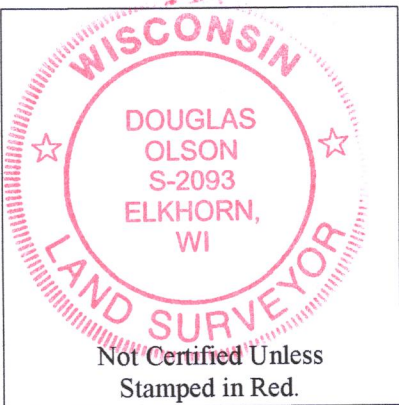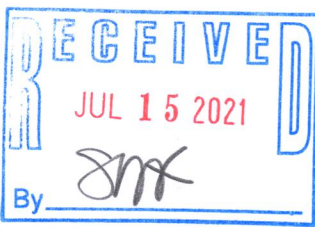

Notes:

- 1) This Plat of Survey is not certified unless signed and sealed in red ink.
- 2) This survey is subject to Wisconsin lien laws. This Plat of Survey is the notice of intent to file lien. Lien waiver required.
- 3) The Survey Date shown on this Plat of Survey is the completion date of the field work.


Copyright © 2021 by Olson Land Surveying, LLC.

All rights reserved. No part of this survey plat may be reproduced or transmitted in any form by any means - graphic, electronic, or mechanical, including photocopying, tracing, or information storage and retrieval systems - without permission in writing from Douglas G. Olson, Olson Land Surveying, LLC.

I hereby certify that I have surveyed the above described property in compliance with Chapter A-E 7 of the Wisconsin Administrative Code and that the map hereon is correct to the best of my professional knowledge and belief and shows the size and location of the property, its exterior boundaries, the location and dimensions of all visible structures thereon, boundary fences, apparent easements and roadways and visible encroachments, if any.

This survey is made for the exclusive use of the present owners of the property, and also those who purchase, mortgage or guarantee title thereto, within one year from the date hereof.

Douglas G. Olson
Wisconsin Professional Land Surveyor - 2093

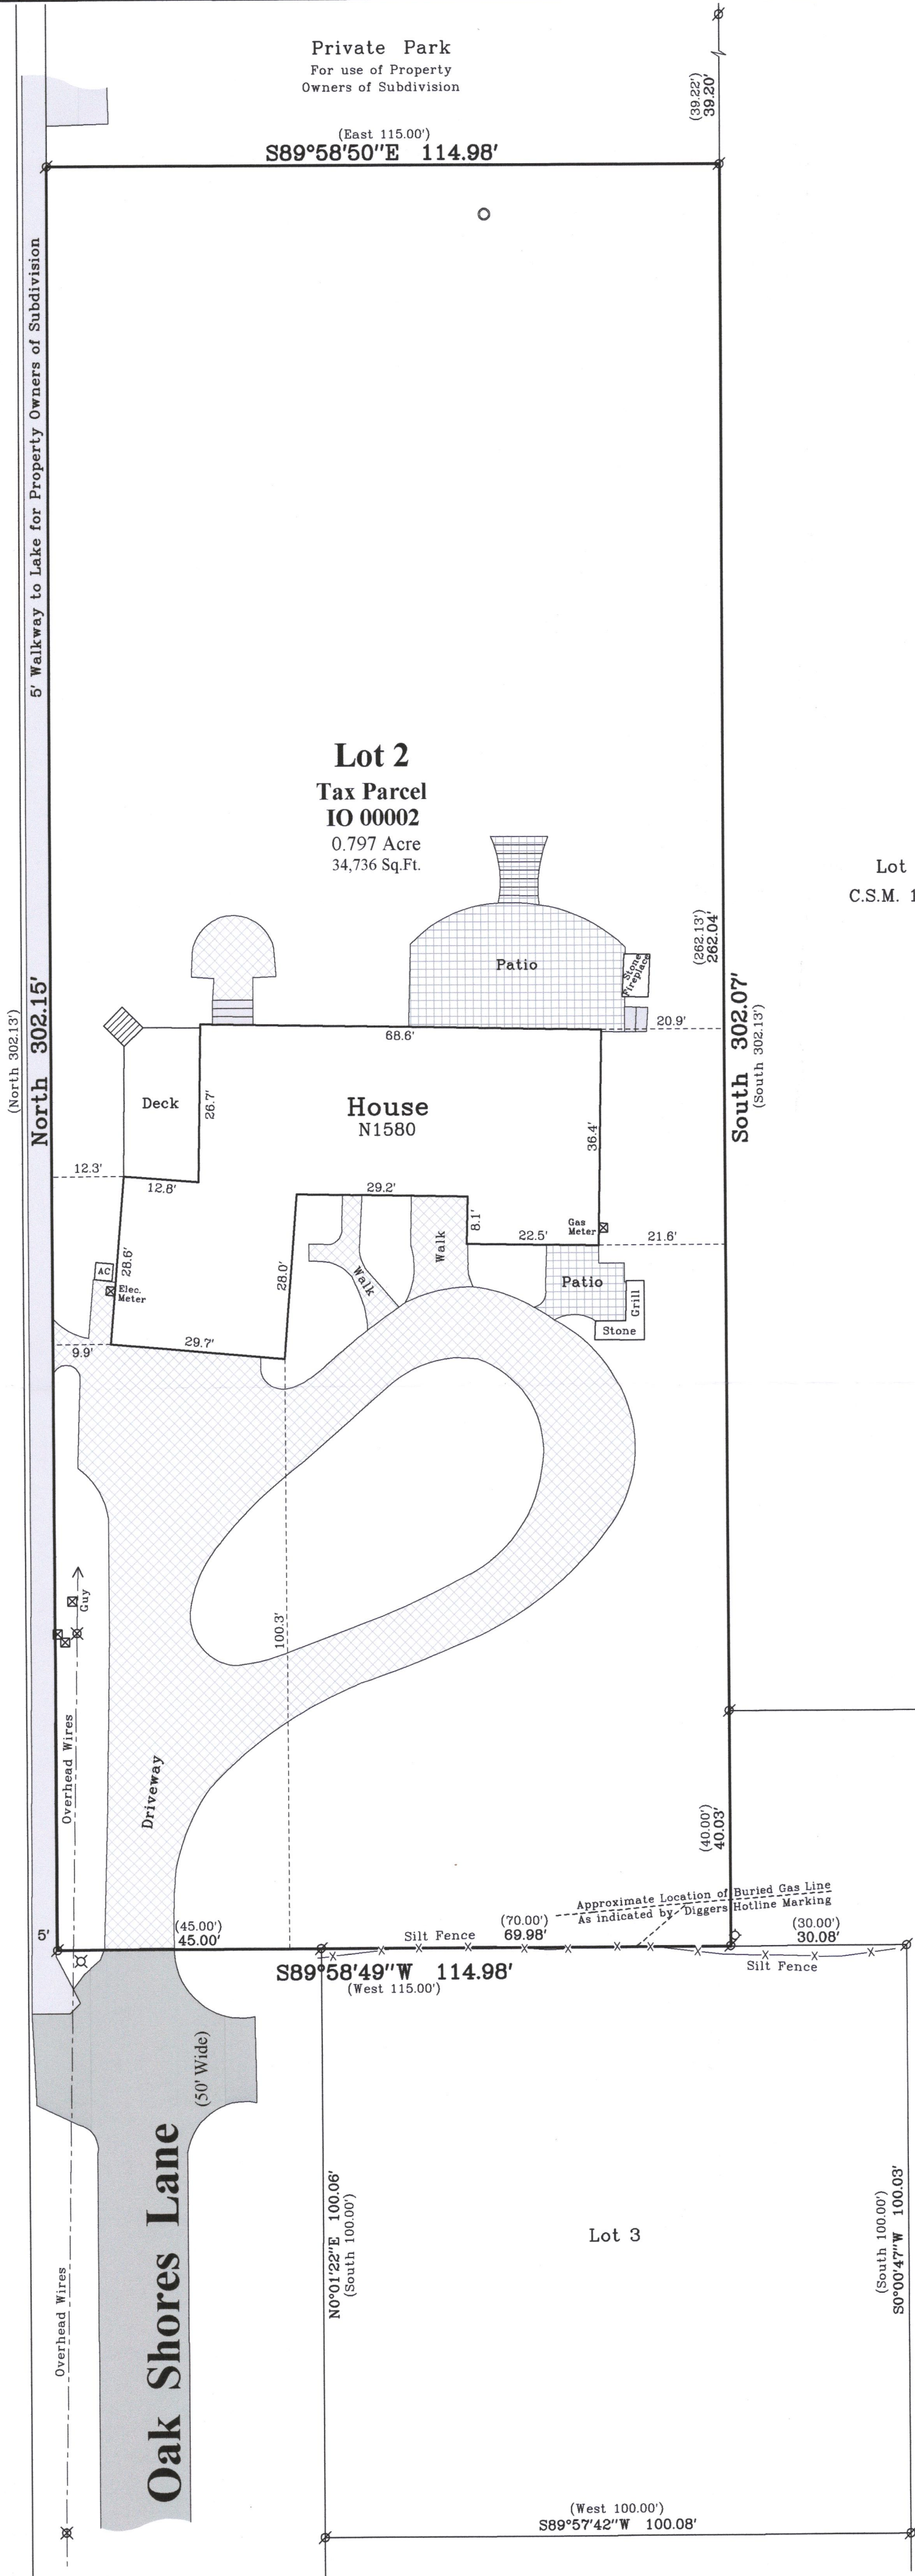

Tax Parcel
IL 1800020D

Lot 1
C.S.M. 1519

Lot 2
C.S.M. 1519

Lot 3

Sheet 1 of 1 Sheets

Drawing Name:

Job Reference Number
2020.119

Legend of Symbols & Abbreviations

- Found Iron Pipe
- Recorded Information
- Utility Pole
- Manhole
- Water Valve
- Asphalt Surface
- Concrete Surface
- Stone Surface
- Brick Pavers
- North
- South
- East
- West
- In Bearings
- Degrees
- Minutes
- Seconds
- In Distances
- Feet
- Inches



45 South Wisconsin Street | P.O. Box 322
Elkhorn, Wisconsin. 53121
Telephone: (262) 723-3434
Facsimile: (262) 723-8044
Email: doug@olsonsurveying.com
Website: www.olsonsurveying.com

Scale in Feet
1" = 20'



Survey Date: March 8, 2021.
Revisions:

2020.119

7D-2

117-4536