


PLAT OF SURVEY


A PARCEL OF LAND LOCATED IN THE NORTHEAST 1/4 OF THE SOUTHWEST 1/4 AND THE NORTHWEST 1/4 OF THE SOUTHEAST 1/4 OF SECTION 16 IN TOWNSHIP 1 NORTH, RANGE 17 EAST, IN THE TOWN OF LINN, WALWORTH COUNTY, WISCONSIN.

MORE PARTICULARLY DESCRIBED AS:
LOT 37 OF THE WOODSTONE SUBDIVISION RECORDED IN DOCUMENT NO. 620174 PER THE WALWORTH COUNTY REGISTER OF DEEDS.

RECEIVED
SEP - 7 2021
By *8mk*

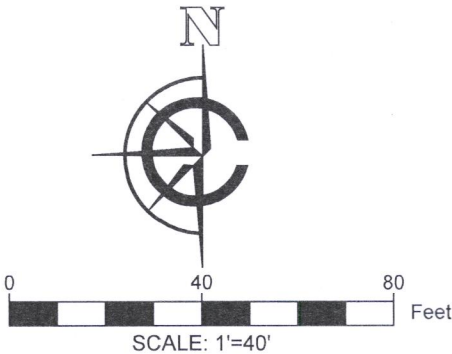

- LEGEND
- FOUND IRON ROD
 - SET 1" IRON PIPE
 - (XX) RECORDED AS

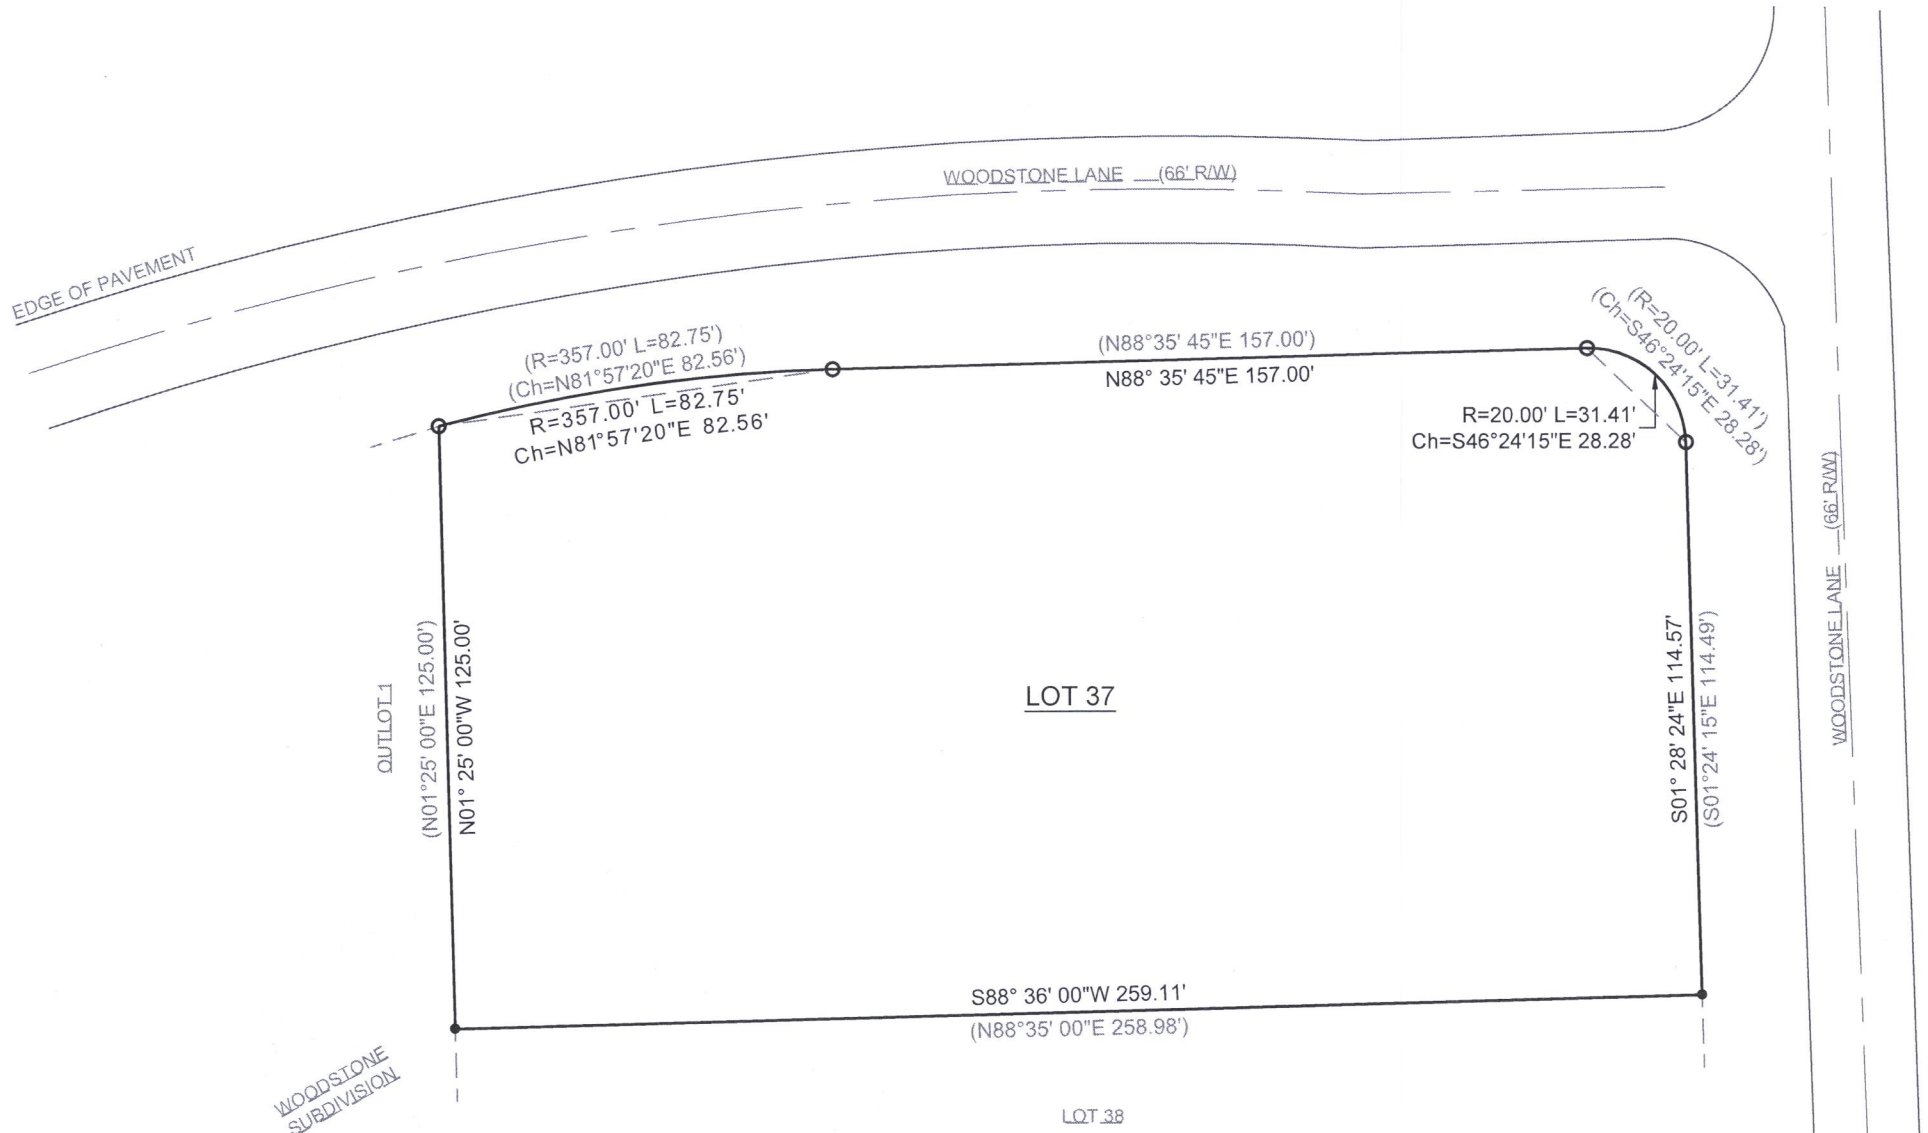

- NOTE:
1. BASIS OF BEARING:
THE WISCONSIN STATE PLANE COORDINATE SYSTEM, NAD-83, SOUTH ZONE.
 2. FIELD WORK COMPLETED ON:
AUGUST 19, 2021
 3. BUILDING SURVEYED TO:
THE EXTERIOR OF SIDING.
 4. FIELD CREW CHIEF
RAYMOND MCARDLE
- SURVEY ORDERED BY:
MARGARET CANFIELD
- PROPERTY ADDRESS:
LOT 37
WOODSTONE SUBDIVISION
TOWN OF LINN
- SURVEYOR:
PAUL H. VAN HENKELUM, PLS
CARDINAL ENGINEERING LLC



"I HEREBY CERTIFY THAT I HAVE SURVEYED THE ABOVE DESCRIBED PROPERTY AND THE MAP IS A TRUE AND CORRECT REPRESENTATION OF ITS EXTERIOR BOUNDARIES AND SHOWS THE SIZE AND LOCATION OF ALL VISIBLE STRUCTURES, APPARENT EASEMENTS AND ENCROACHMENTS, IF ANY.

Paul H. Van Henkelum *9/2/2021*
PAUL H VAN HENKELUM, PLS #1931 DATE

CARDINAL ENGINEERING LLC
DESIGNING IN TRUE DIRECTIONS

PO BOX 281 - 1200 LA SALLE ST.
LAKE GENEVA, WI 53147
262-757-8776
CARDINALENGINEERINGWI.COM

DATE: 09 / 02 / 2021 JOB No. 21473
SHEET 1 OF 1 LWG

IWO-37

117-4557