



# PLAT OF SURVEY LOTS 13 THRU 16 OF BLOCK 2

SUNSET HILLS SUBDIVISION  
LOCATED IN THE NW 1/4 SECTION 4  
TOWN 1 NORTH, RANGE 17 EAST  
WALWORTH COUNTY, WISCONSIN

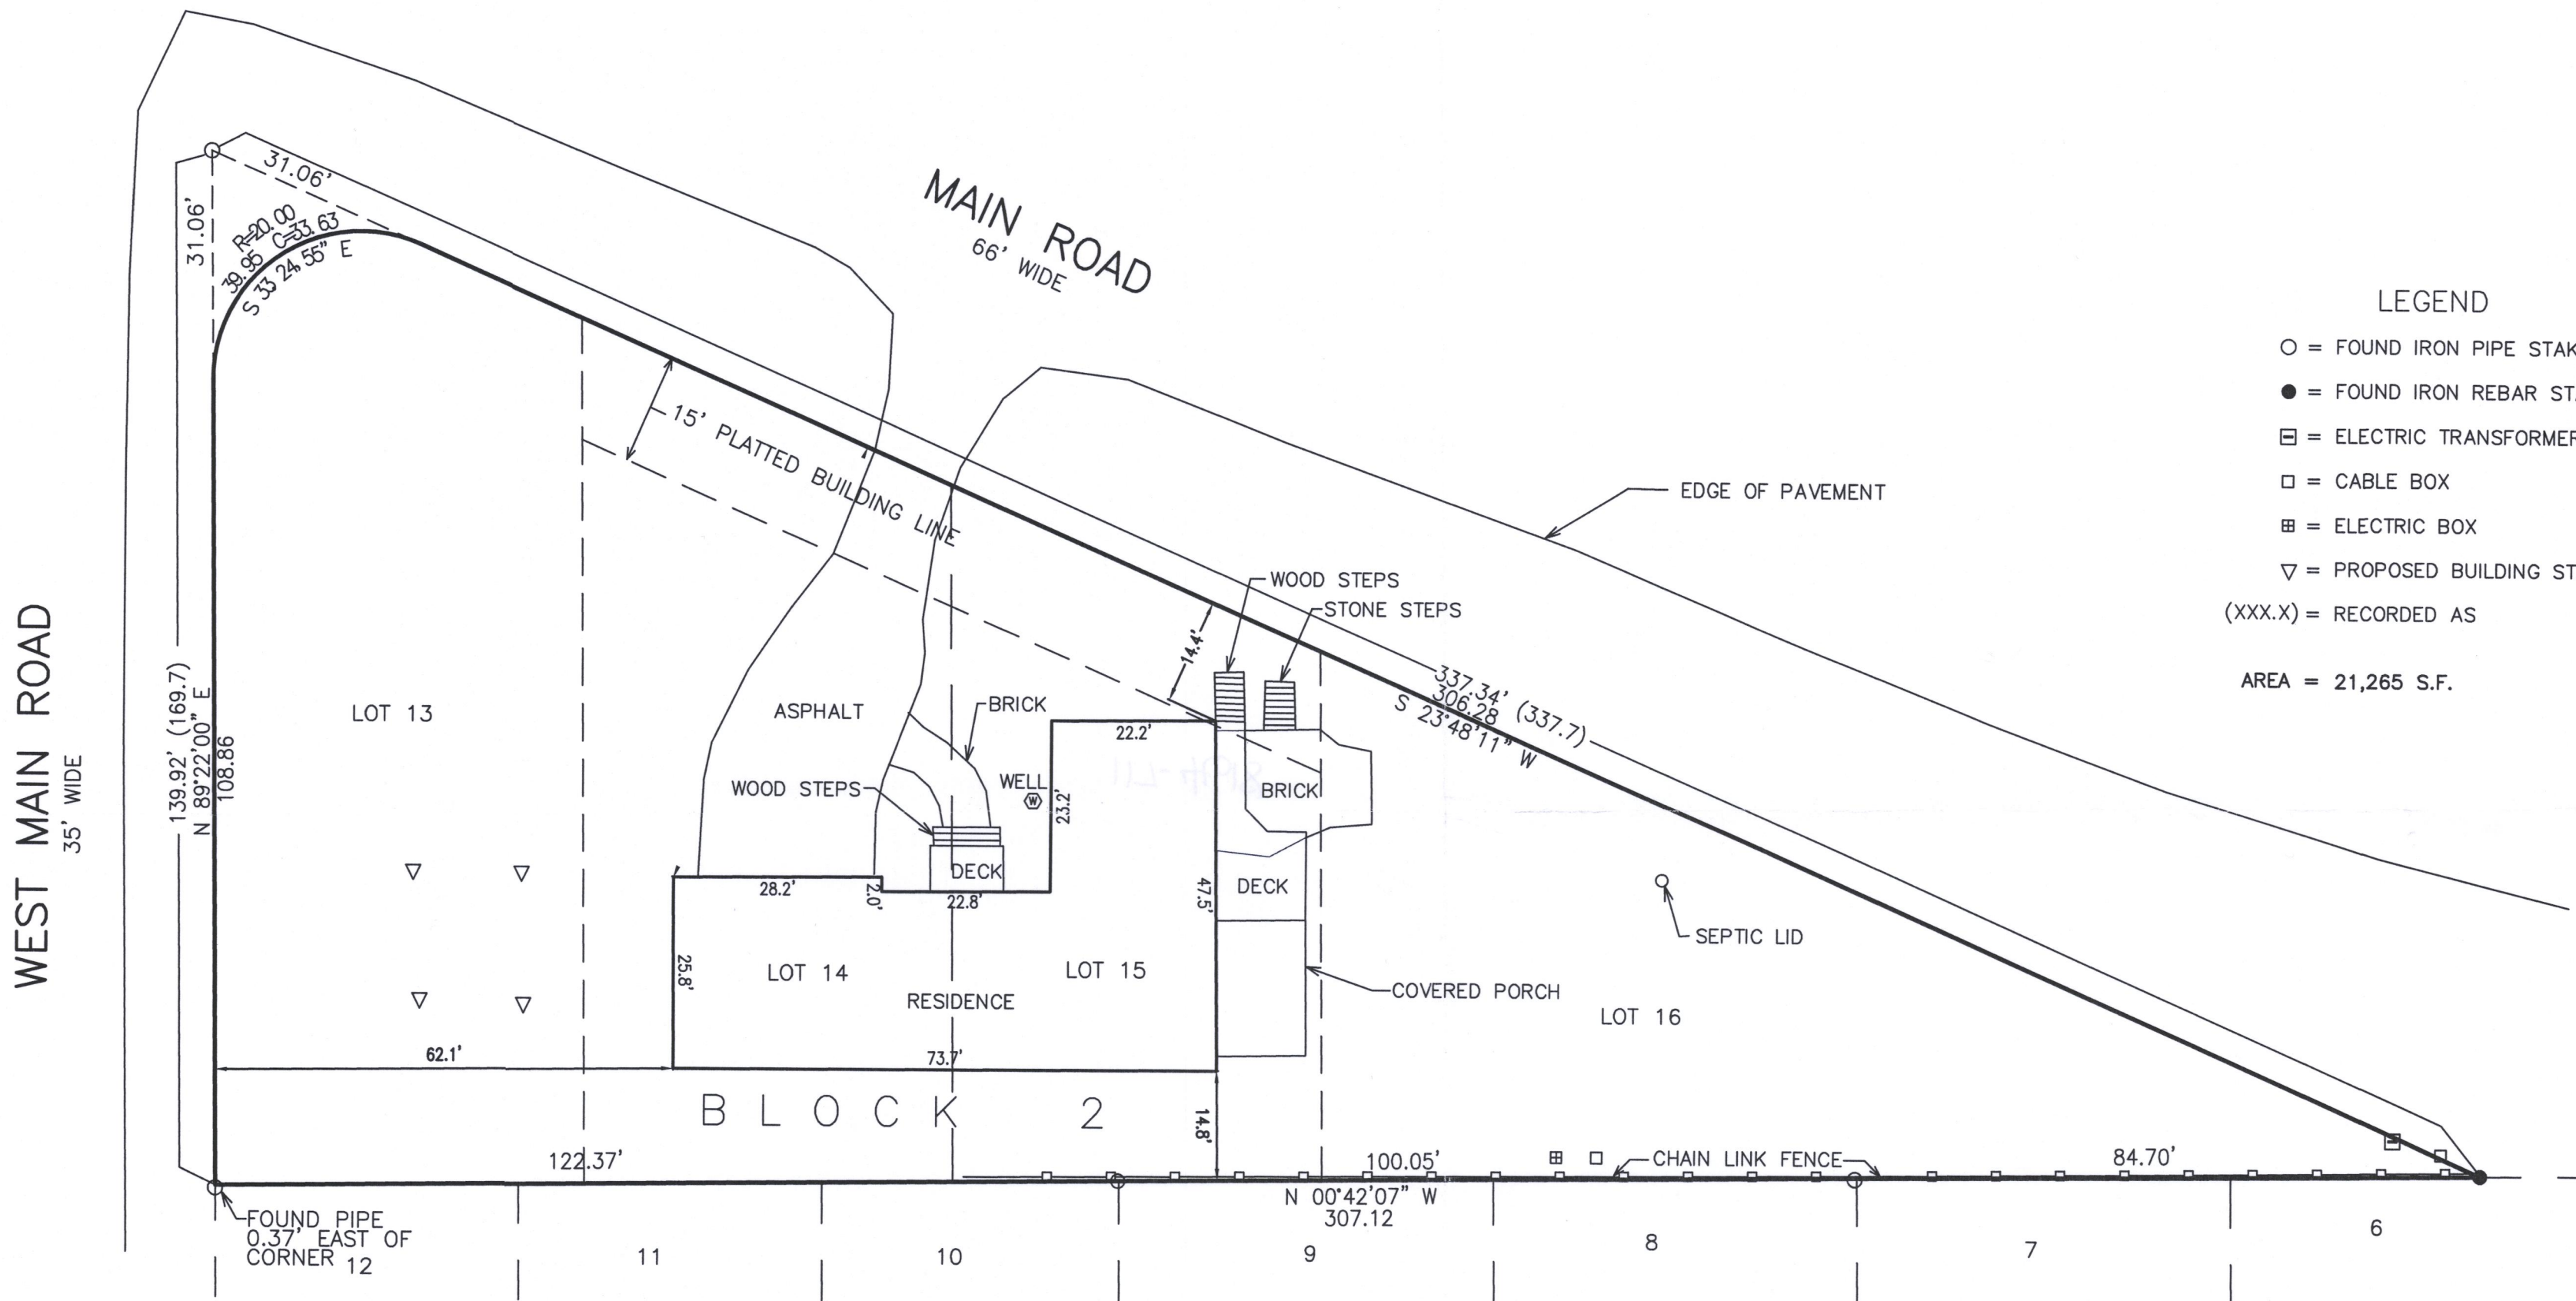

- LEGEND
- = FOUND IRON PIPE STAKE
  - = FOUND IRON REBAR STAKE
  - ⊞ = ELECTRIC TRANSFORMER
  - = CABLE BOX
  - ⊞ = ELECTRIC BOX
  - ▽ = PROPOSED BUILDING STAKES LOCATED
  - (XXX.X) = RECORDED AS
  - AREA = 21,265 S.F.

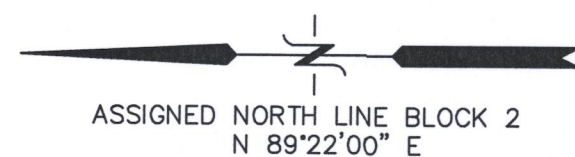

NOTE: COPIES OF THIS MAP TO WHICH THE FOLLOWING CERTIFICATE WILL APPLY SHOW THE SURVEYOR'S ORIGINAL SEAL AND SIGNATURE IN RED INK. COPIES BY ANY OTHER MEANS MAY HAVE ALTERATIONS WHICH DO NOT REPRESENT THE SURVEYOR'S WORK PRODUCT.

I HEREBY CERTIFY THAT THE ABOVE DESCRIBED PROPERTY HAS BEEN SURVEYED UNDER MY DIRECTION AND THAT THE ABOVE MAP IS A TRUE REPRESENTATION THEREOF AND SHOWS THE SIZE AND LOCATION OF THE PROPERTY AND ITS EXTERIOR BOUNDARIES. THIS SURVEY IS MADE FOR THE USE OF THE PRESENT OWNERS OF THE PROPERTY, AND ALSO THOSE WHO PURCHASE, MORTGAGE, OR GUARANTEE THE TITLE THERETO WITHIN ONE YEAR FROM THE DATE HEREOF.

DATED: 01/05/2022

*Christopher A. Hodges*  
CHRISTOPHER A. HODGES P.L.S. 2760



PLAT OF SURVEY  
N2391 MAIN ROAD  
LAKE GENEVA, WISCONSIN 53147

WORK ORDERED BY -  
JARZEMSKY TRUST / DANIEL JARZEMSKY  
N2391 MAIN ROAD  
LAKE GENEVA, WISCONSIN 53147

FARRIS, HANSEN & ASSOCIATES, INC.  
ENGINEERING - ARCHITECTURE - SURVEYING  
7 RIDGWAY COURT P.O. BOX 437  
ELKHORN, WISCONSIN 53121  
OFFICE: (262) 723-2098 FAX: (262) 723-5886

REVISIONS

PROJECT NO.  
8905.21  
DATE:  
01/05/2022  
SHEET NO.  
1 OF 1

15H-23

117-4618