


PLAT OF SURVEY LOT 2 of CSM 1323

PART OF THE SW 1/4 OF THE SW 1/4 OF SECTION 11, TOWN 1 NORTH, RANGE 17 EAST
TOWN OF LINN, WALWORTH COUNTY, WISCONSIN

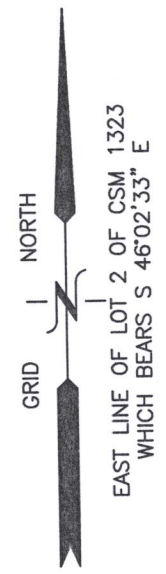

CONSTRUCTION SEQUENCE

- 1) SILT FENCING INSTALLED
- 2) VEGETATION TO BE CLEARED
- 3) TOPSOIL STRIPPED
- 4) FOUNDATIONS DUG & POURED
- 5) WALLS BACKFILLED (WASTE EXCESS OFFSITE)
- 6) FRAMING & HOME CONSTRUCTION COMPLETED
- 7) DRIVE & LANDSCAPING COMPLETED

AREA TO BE RESTORED WITH TOPSOIL AS SOON AFTER FOUNDATION AND FRAMING AS POSSIBLE FOLLOWED WITH GRASS SEEDING AND MULCH.

AREA WITHIN SILT FENCING TO BE CLEARED OF UNDERBRUSH WITH ONLY NECESSARY LARGE TREES REMOVED.

NOTE: ALL SILT FENCING SHALL BE MAINTAINED IN A STABLE CONDITION FULLY BRACED AND STAKED TO PREVENT MOVEMENT BY RUNOFF UNTIL A DENSE TURF IS ESTABLISHED OVER ALL DISTURBED GROUND SURFACES. DURING OR AFTER EVERY STORM THEY SHALL BE CHECKED. ACCUMULATIONS OF SILT TOPSOIL AND ANY OTHER CONSTRUCTION DEBRIS SHALL BE ROUTINELY REMOVED.

LEGEND

- = IRON PIPE FOUND
- = IRON REBAR FOUND
- ⊕ = UTILITY POLE
- {xxx} = RECORDED AS
- OH— = OVERHEAD UTILITY WIRES
- +xxxx = EXISTING GROUND ELEVATION
- xxxx--- = EXISTING LAND CONTOURS
- F.F. = FIRST FLOOR ELEVATION
- G.E. = GARAGE ELEVATION



NOTE: COPIES OF THIS MAP TO WHICH THE FOLLOWING CERTIFICATE WILL APPLY SHOW THE SURVEYOR'S ORIGINAL SEAL AND SIGNATURE IN RED INK. COPIES BY ANY OTHER MEANS MAY HAVE ALTERATIONS WHICH DO NOT REPRESENT THE SURVEYOR'S WORK PRODUCT.

I HEREBY CERTIFY THAT THE ABOVE DESCRIBED PROPERTY HAS BEEN SURVEYED UNDER MY DIRECTION AND THAT THE ABOVE MAP IS A TRUE REPRESENTATION THEREOF AND SHOWS THE SIZE AND LOCATION OF THE PROPERTY AND ITS EXTERIOR BOUNDARIES. THIS SURVEY IS MADE FOR THE USE OF THE PRESENT OWNERS OF THE PROPERTY, AND ALSO THOSE WHO PURCHASE, MORTGAGE, OR GUARANTEE THE TITLE THERETO WITHIN ONE YEAR FROM THE DATE HEREOF.

DATED: 6/28/2022

Christopher A. Hodges
CHRISTOPHER A. HODGES P.L.S. 2760




BOUNDARY SURVEY
N1716 DURAND LANE
LAKE GENEVA, WI 53147

WORK ORDERED BY -
KATIE CARLSON
N1716 DURAND LANE
LAKE GENEVA, WI 53147

FARRIS, HANSEN & ASSOCIATES, INC.
ENGINEERING - ARCHITECTURE - SURVEYING
7 RIDGWAY COURT P.O. BOX 437
ELKHORN, WISCONSIN 53121
OFFICE: (262) 723-2098 FAX: (262) 723-5886

REVISIONS

PROJECT NO.	10707
DATE:	6/28/2022
SHEET NO.	1 OF 1

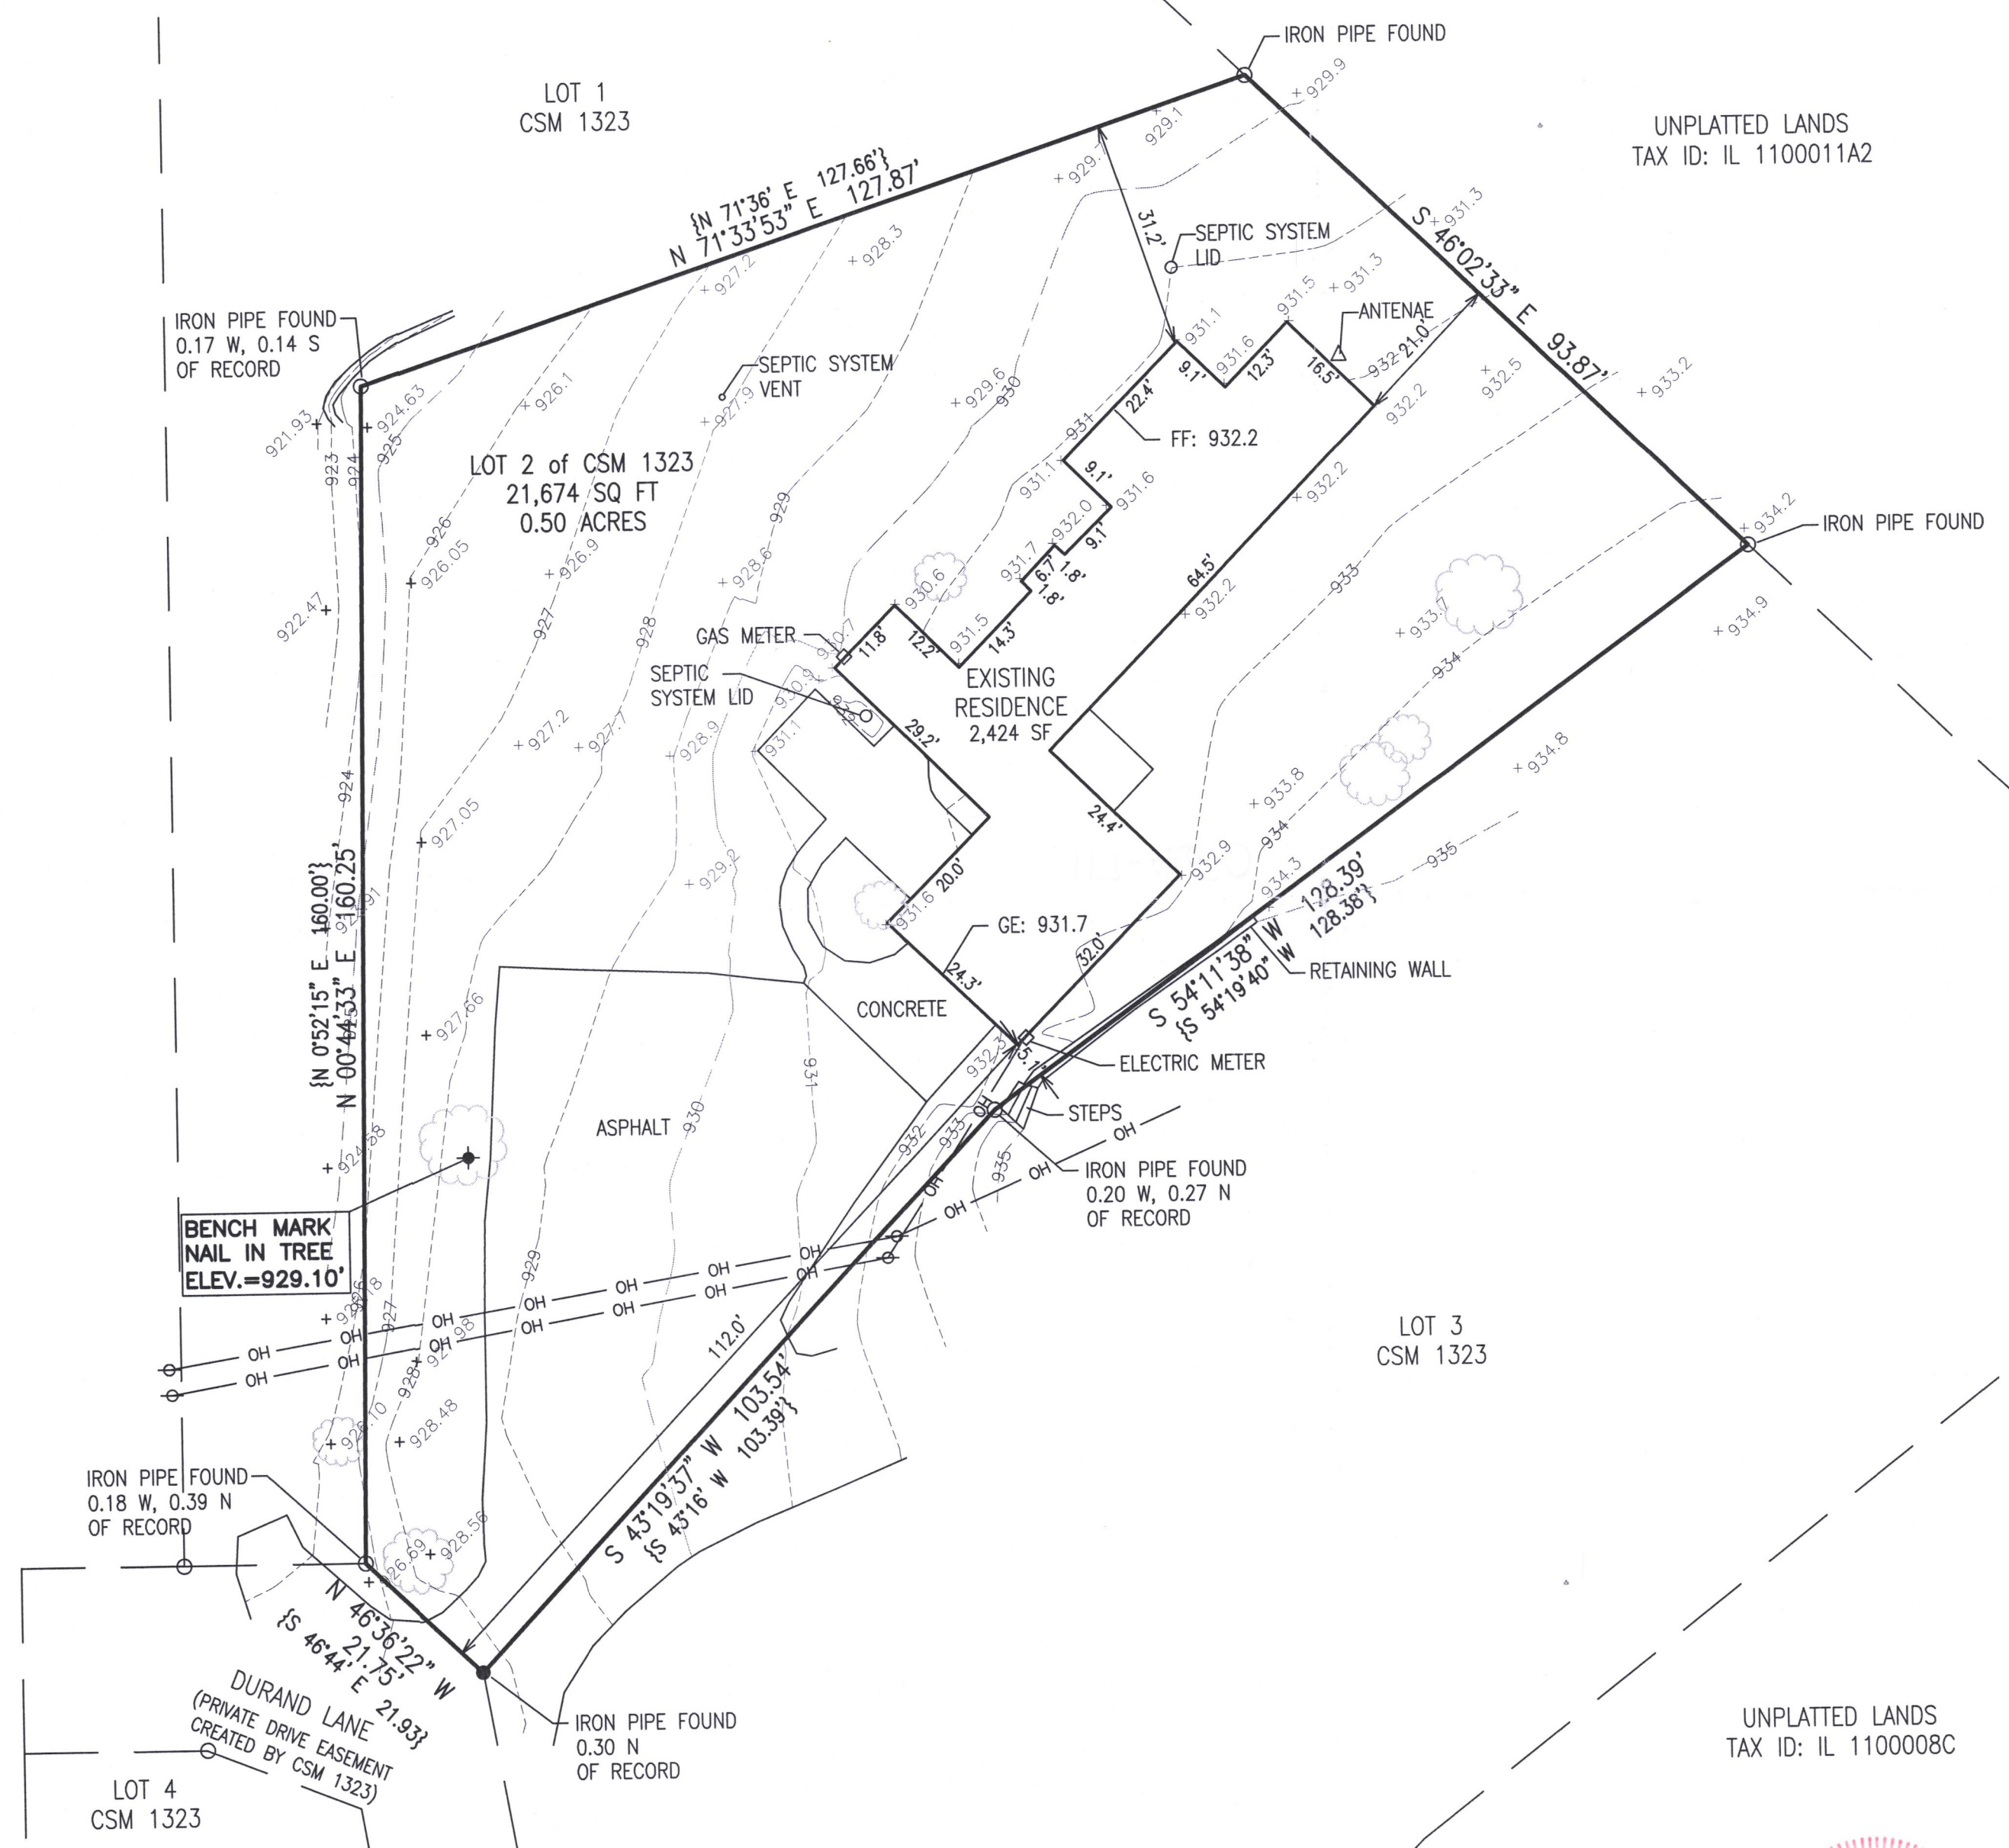

BENCH MARK
NAIL IN TREE
ELEV.=929.10'

IRON PIPE FOUND
0.18 W, 0.39 N
OF RECORD

DURAND LANE
(PRIVATE DRIVE EASEMENT
CREATED BY CSM 1323)

LOT 4
CSM 1323

LOT 3
CSM 1323

UNPLATTED LANDS
TAX ID: IL 1100011A2

UNPLATTED LANDS
TAX ID: IL 1100008C



X:\PROJECTS\10707\ACAD\10707-0.dwg

IA1323-2

117-4670