

PLAT OF SURVEY

A PARCEL OF LAND LOCATED IN THE NORTHEAST 1/4 OF THE SOUTHWEST 1/4 OF SECTION 9 IN TOWNSHIP 1 NORTH, RANGE 17 EAST, IN THE TOWN OF LINN, WALWORTH COUNTY, WISCONSIN.

MORE PARTICULARLY DESCRIBED AS:

LOT 9 OF THE WOODDALE ADDITION SUBDIVISION AS RECORDED IN DOCUMENT NO. P255821 AS PER THE WALWORTH COUNTY REGISTER OF DEEDS. ALSO EXCLUDING: COMMENCING FROM THE SOUTHWEST CORNER OF SAID LOT 9 BEING THE PLACE OF BEGINNING; THENCE N22° 48' 16"W 153.39' TO A POINT ON THE MEANDER LINE OF GENEVA LAKE; THENCE N62° 25' 36"E 20.07' ALONG SAID MEANDER LINE TO A SET 1" IRON PIPE; THENCE S22° 48' 16"E 157.44' TO A FOUND IRON ROD ON THE NORTHERLY RIGHT OF WAY OF BLUFF LANE; THENCE S65° 24' 17"W 20.01' ALONG SAID RIGHT OF WAY TO THE PLACE OF BEGINNING. INCLUDING ALL LAND BETWEEN SAID MEANDER LINE AND GENEVA LAKE

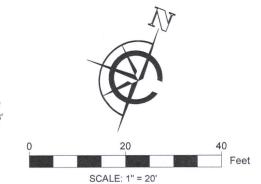

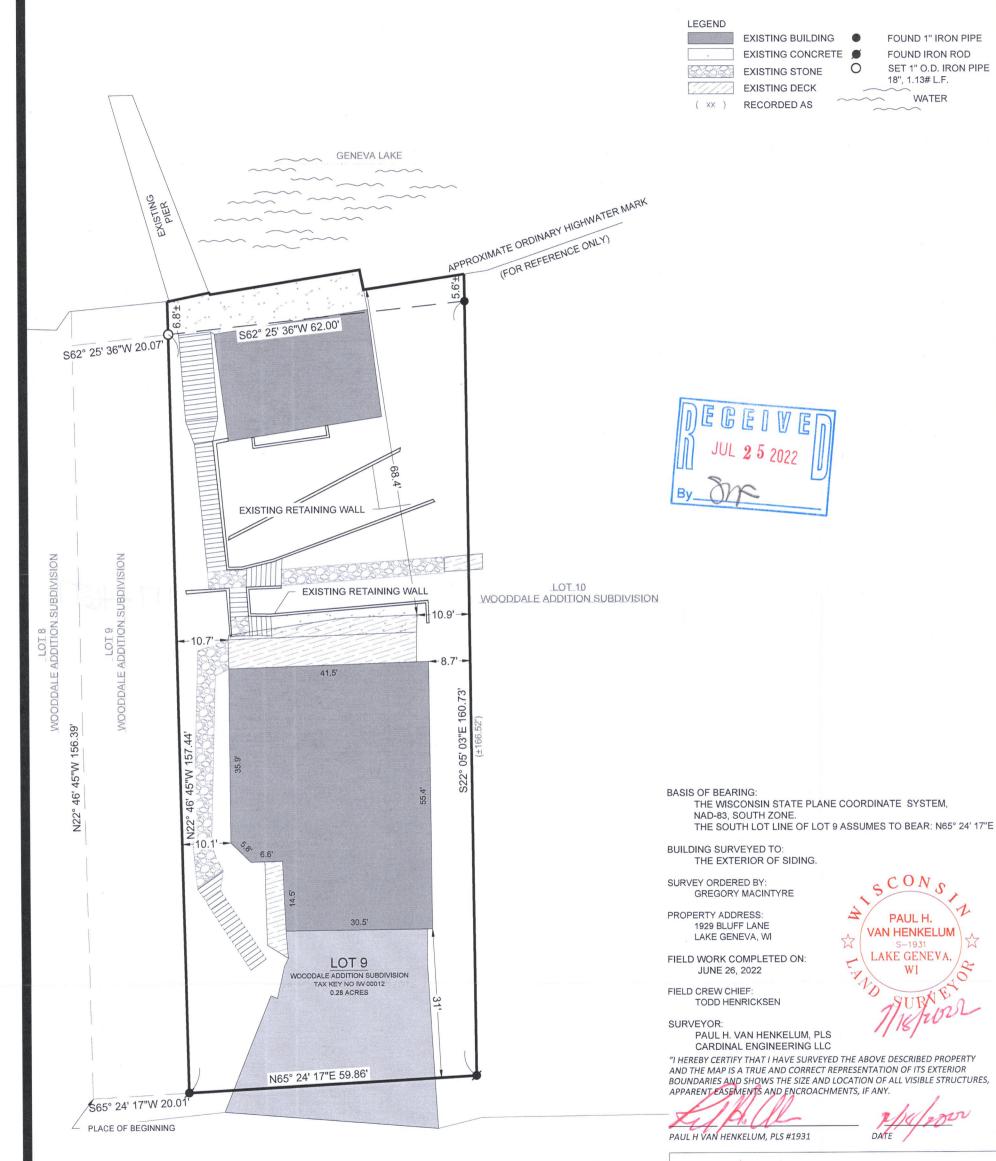



CARDINAL PLAN | SURVEY | ENGINEER

1200 LA SALLE ST. LAKE GENEVA, WI 53147 262-757-8776 PLANSURVEYENGINEER.COM

DATE: 07/14/2022

JOB No. 22361 EJO

(LAKEVIEW ROAD) BLUFF LANE

40' PUBLIC RIGHT OF WAY