



Plat of Survey

of

Lot 22 of Lake Geneva Highlands,


a subdivision, located in Government Lot 1 in the Southeast 1/4 of Section 8, Town 1 North, Range 17 East, Town of Linn, Walworth County, Wisconsin.

Surveyed for: **Thomas O'Connor**
5760 South Monroe Street
Hinsdale, Illinois. 60521

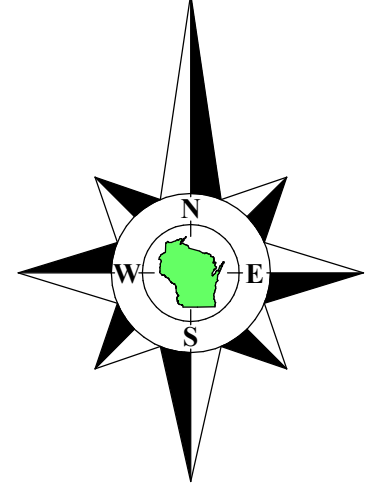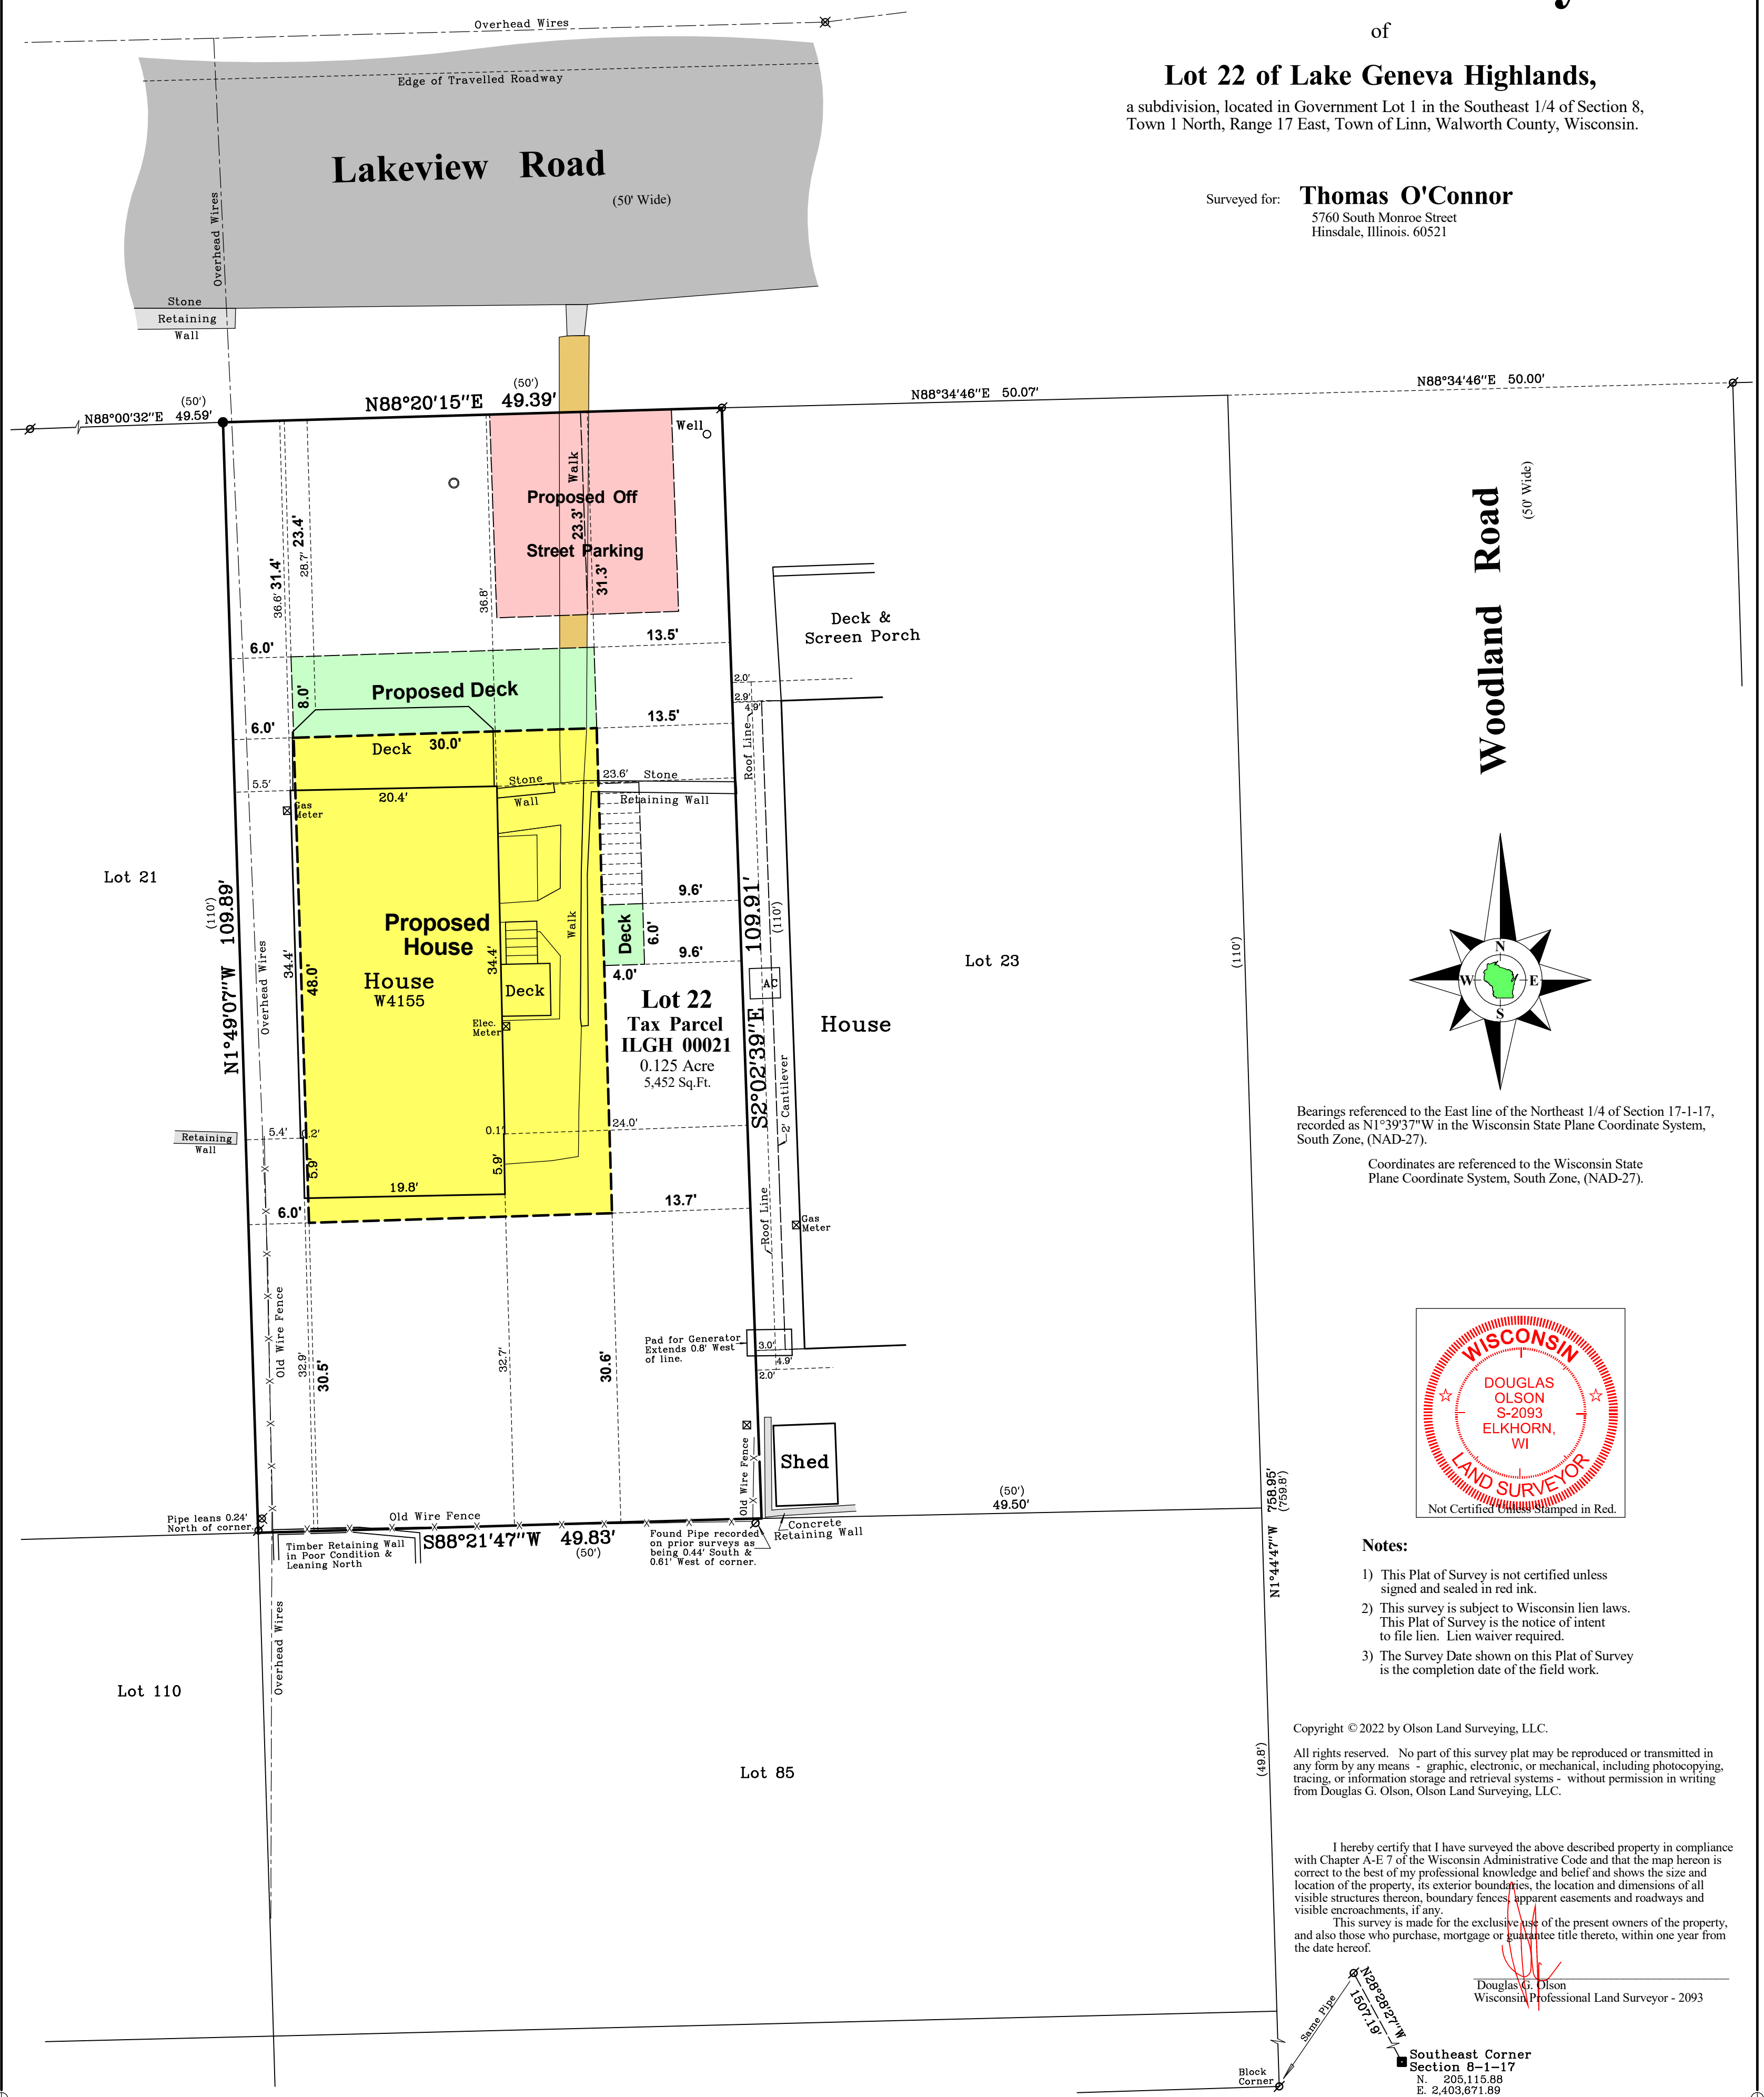

Bearings referenced to the East line of the Northeast 1/4 of Section 17-1-17, recorded as N1°39'37"W in the Wisconsin State Plane Coordinate System, South Zone, (NAD-27).

Coordinates are referenced to the Wisconsin State Plane Coordinate System, South Zone, (NAD-27).

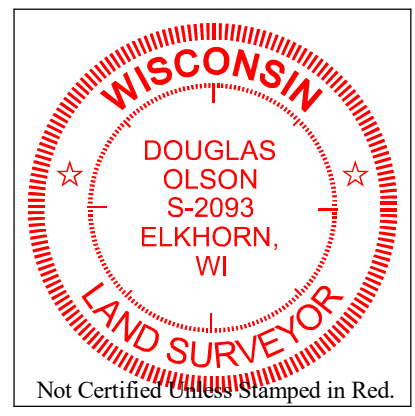

Notes:

- 1) This Plat of Survey is not certified unless signed and sealed in red ink.
- 2) This survey is subject to Wisconsin lien laws. This Plat of Survey is the notice of intent to file lien. Lien waiver required.
- 3) The Survey Date shown on this Plat of Survey is the completion date of the field work.

Copyright © 2022 by Olson Land Surveying, LLC.

All rights reserved. No part of this survey plat may be reproduced or transmitted in any form by any means - graphic, electronic, or mechanical, including photocopying, tracing, or information storage and retrieval systems - without permission in writing from Douglas G. Olson, Olson Land Surveying, LLC.

I hereby certify that I have surveyed the above described property in compliance with Chapter A-E 7 of the Wisconsin Administrative Code and that the map hereon is correct to the best of my professional knowledge and belief and shows the size and location of the property, its exterior boundaries, the location and dimensions of all visible structures thereon, boundary fences, apparent easements and roadways and visible encroachments, if any.

This survey is made for the exclusive use of the present owners of the property, and also those who purchase, mortgage or guarantee title thereto, within one year from the date hereof.

Douglas G. Olson
Wisconsin Professional Land Surveyor - 2093

Block Corner
Same Pipe
N2°28'27"W
1507.19'
Southeast Corner
Section 8-1-17
N. 205,115.88
E. 2,403,871.89

2022.029


Sheet 1 of 1 Sheets
Drawing Name:
Job Reference Number
2022.029

Legend of Symbols & Abbreviations

■ Found County Section Corner	N North
○ Found Iron Pipe	S South
● Found Iron Rod	E East
○ Set Iron Pipe, 1" dia.	W West
○ Recorded Information	In Bearings
⊗ Utility Pole	° Degrees
⊗ Utility Pedestal	" Minutes
⊗ Concrete Cover	" Seconds
⊗ Asphalt Surface	In Distances
⊗ Concrete Surface	Feet
⊗ Stone Pavers	" Inches



45 South Wisconsin Street | P.O. Box 322
Elkhorn, Wisconsin. 53121
Telephone: (262) 723-3434
Facsimile: (262) 723-8044
Email: doug@olsonsurveying.com
Website: www.olsonsurveying.com

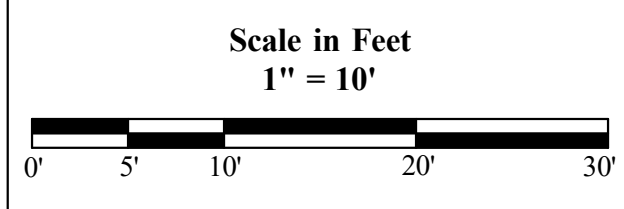

Survey Date: March 21, 2022.
Revisions: No. 1 - Proposed House & Deck
No. 2 - Impervious Surface Calc.
No. 3 - Proposed Off Street Parking