
## Plat of Survey

## Lot 1 of Certified Survey Map No. 2390,


recorded in Vol. 12 of Certified Survey Maps of Walworth County on Page 1 and located in the Southeast 1/4 of the Northwest 1/4 and the Southwest 1/4 of the Northeast 1/4 all in Section 17, Town 1 North, Range 17 East, Town of Linn, Walworth County, Wisconsin.


Surveyed for: Charles Vogel N1580 Oak Shores Lane Fontana, Wisconsin. 53125

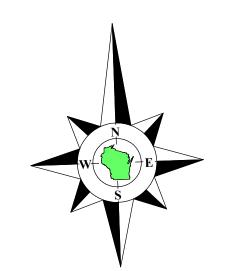

Bearings referenced to the East line of Lot 1 of Certified Survey Map No. 1926, recorded as S0°31'33"W, which produces a bearing of S89°26'49"E on the South line of the Northeast 1/4 of Section 17-1-17. A rotation of 1°50'52" from the Wisconsin State Plane Coordinate System, South Zone, (NAD-27).

Coordinates are referenced to the Wisconsin State Plane Coordinate System, South Zone, (NAD-27).

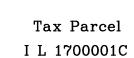

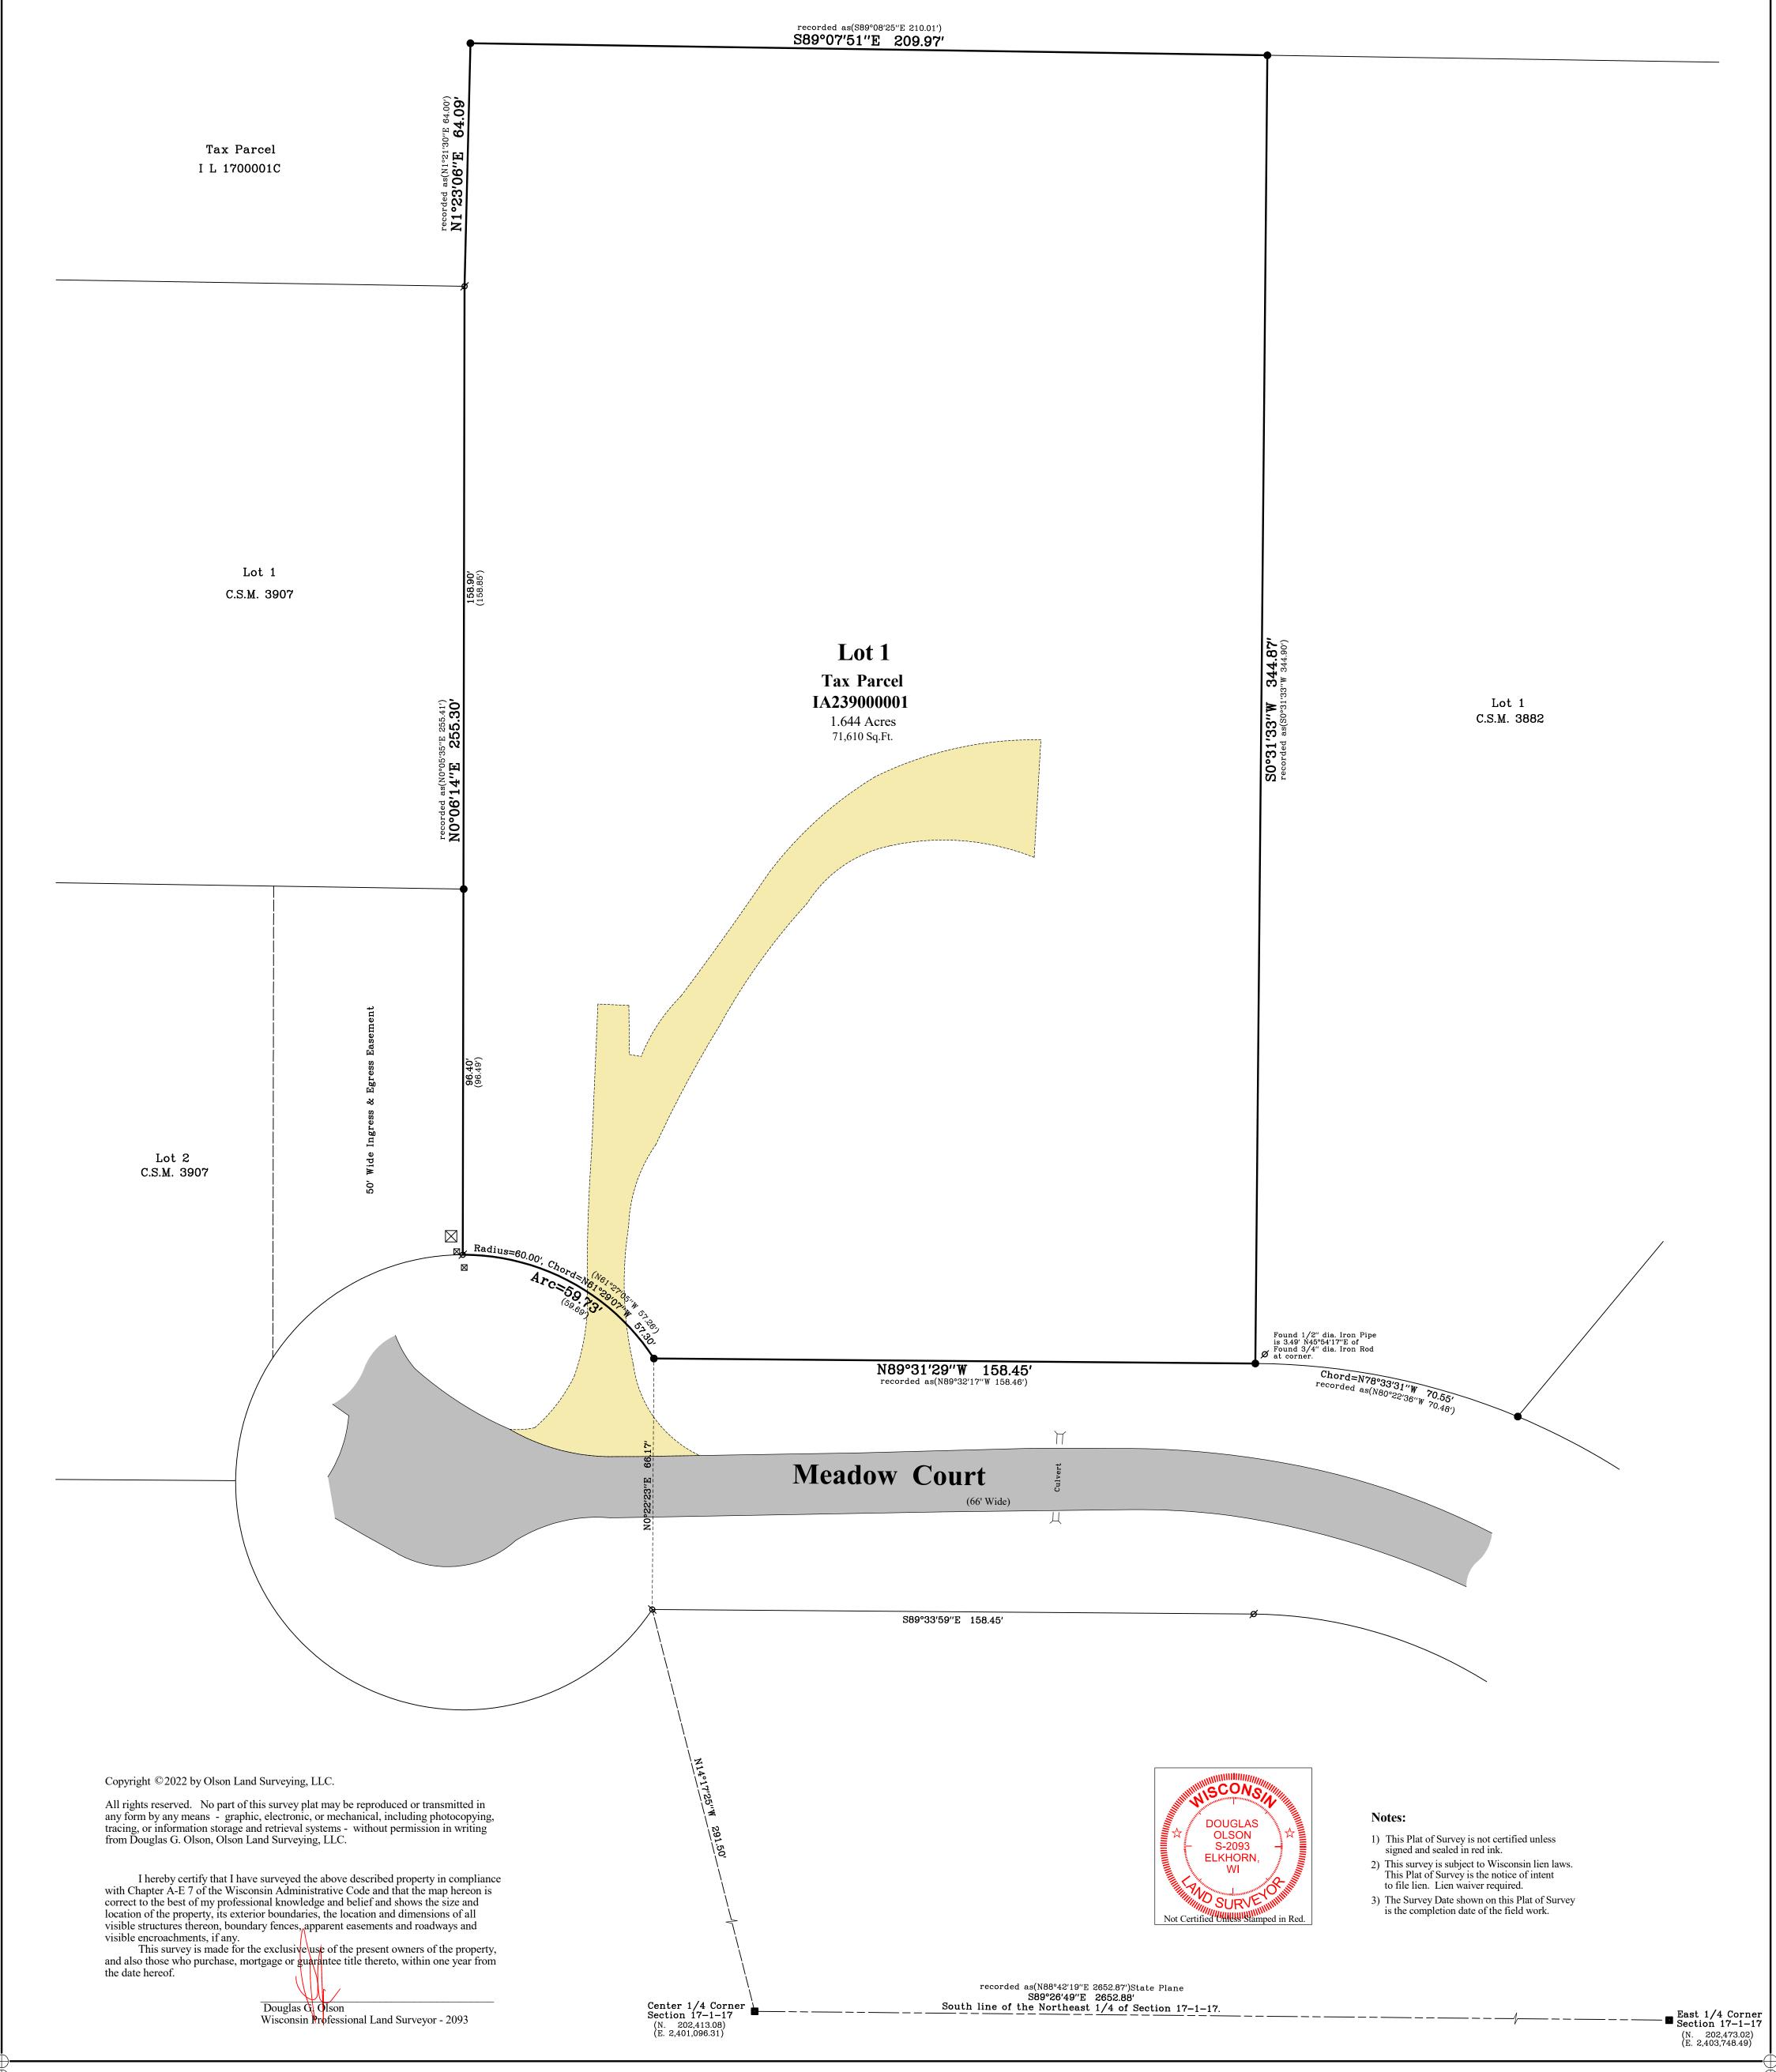

Sheet 1 of 1 Sheets 2022.087 Drawing Name: **Job Reference Number** 2022.087


**Legend** of Symbols & Abbreviations N North
S South
E East
W West
In Bearings
Degrees
Minutes
Seconds
In Distances
Feet
Inches
No. Number
NW. Northwest
NE. Northeast
Dia. Diameter

Found County Section Corner

Found Iron Pipe
Found Iron Rod
O Set Iron Pipe, 1" dia.
() Recorded Information



45 South Wisconsin Street | P.O. Box 322 Elkhorn, Wisconsin. 53121 Telephone: (262) 723-3434 Facsimile: (262) 723-8044 Email: doug@olsonsurveying.com Website: www.olsonsurveying.com

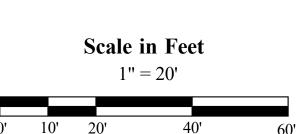

Survey date: June 9, 2022.

Revisions: