


**LOCATION:** N2931 GENEVA OAKS TRAIL, LAKE GENEVA, WI 53147  
**PREPARED FOR:** JOHN LANGELUND and KATHLEEN LANGELUND  
**PROPERTY DESCRIPTION:** Per Document No.: 649456  
Outlot numbered 4 in Geneva Oaks, a subdivision located in Government Lot 3 of the Northwest Quarter of Section 4, Township 1 North, Range 17 East of the Third Principal Meridian, according to the recorded plat thereof on file in the Office of the Register of Deeds in and for Walworth County, Wisconsin.  
**CURRENT OWNER:** JOHN LANGELUND and KATHLEEN LANGELUND  
**TAX ID:** IGO 00026

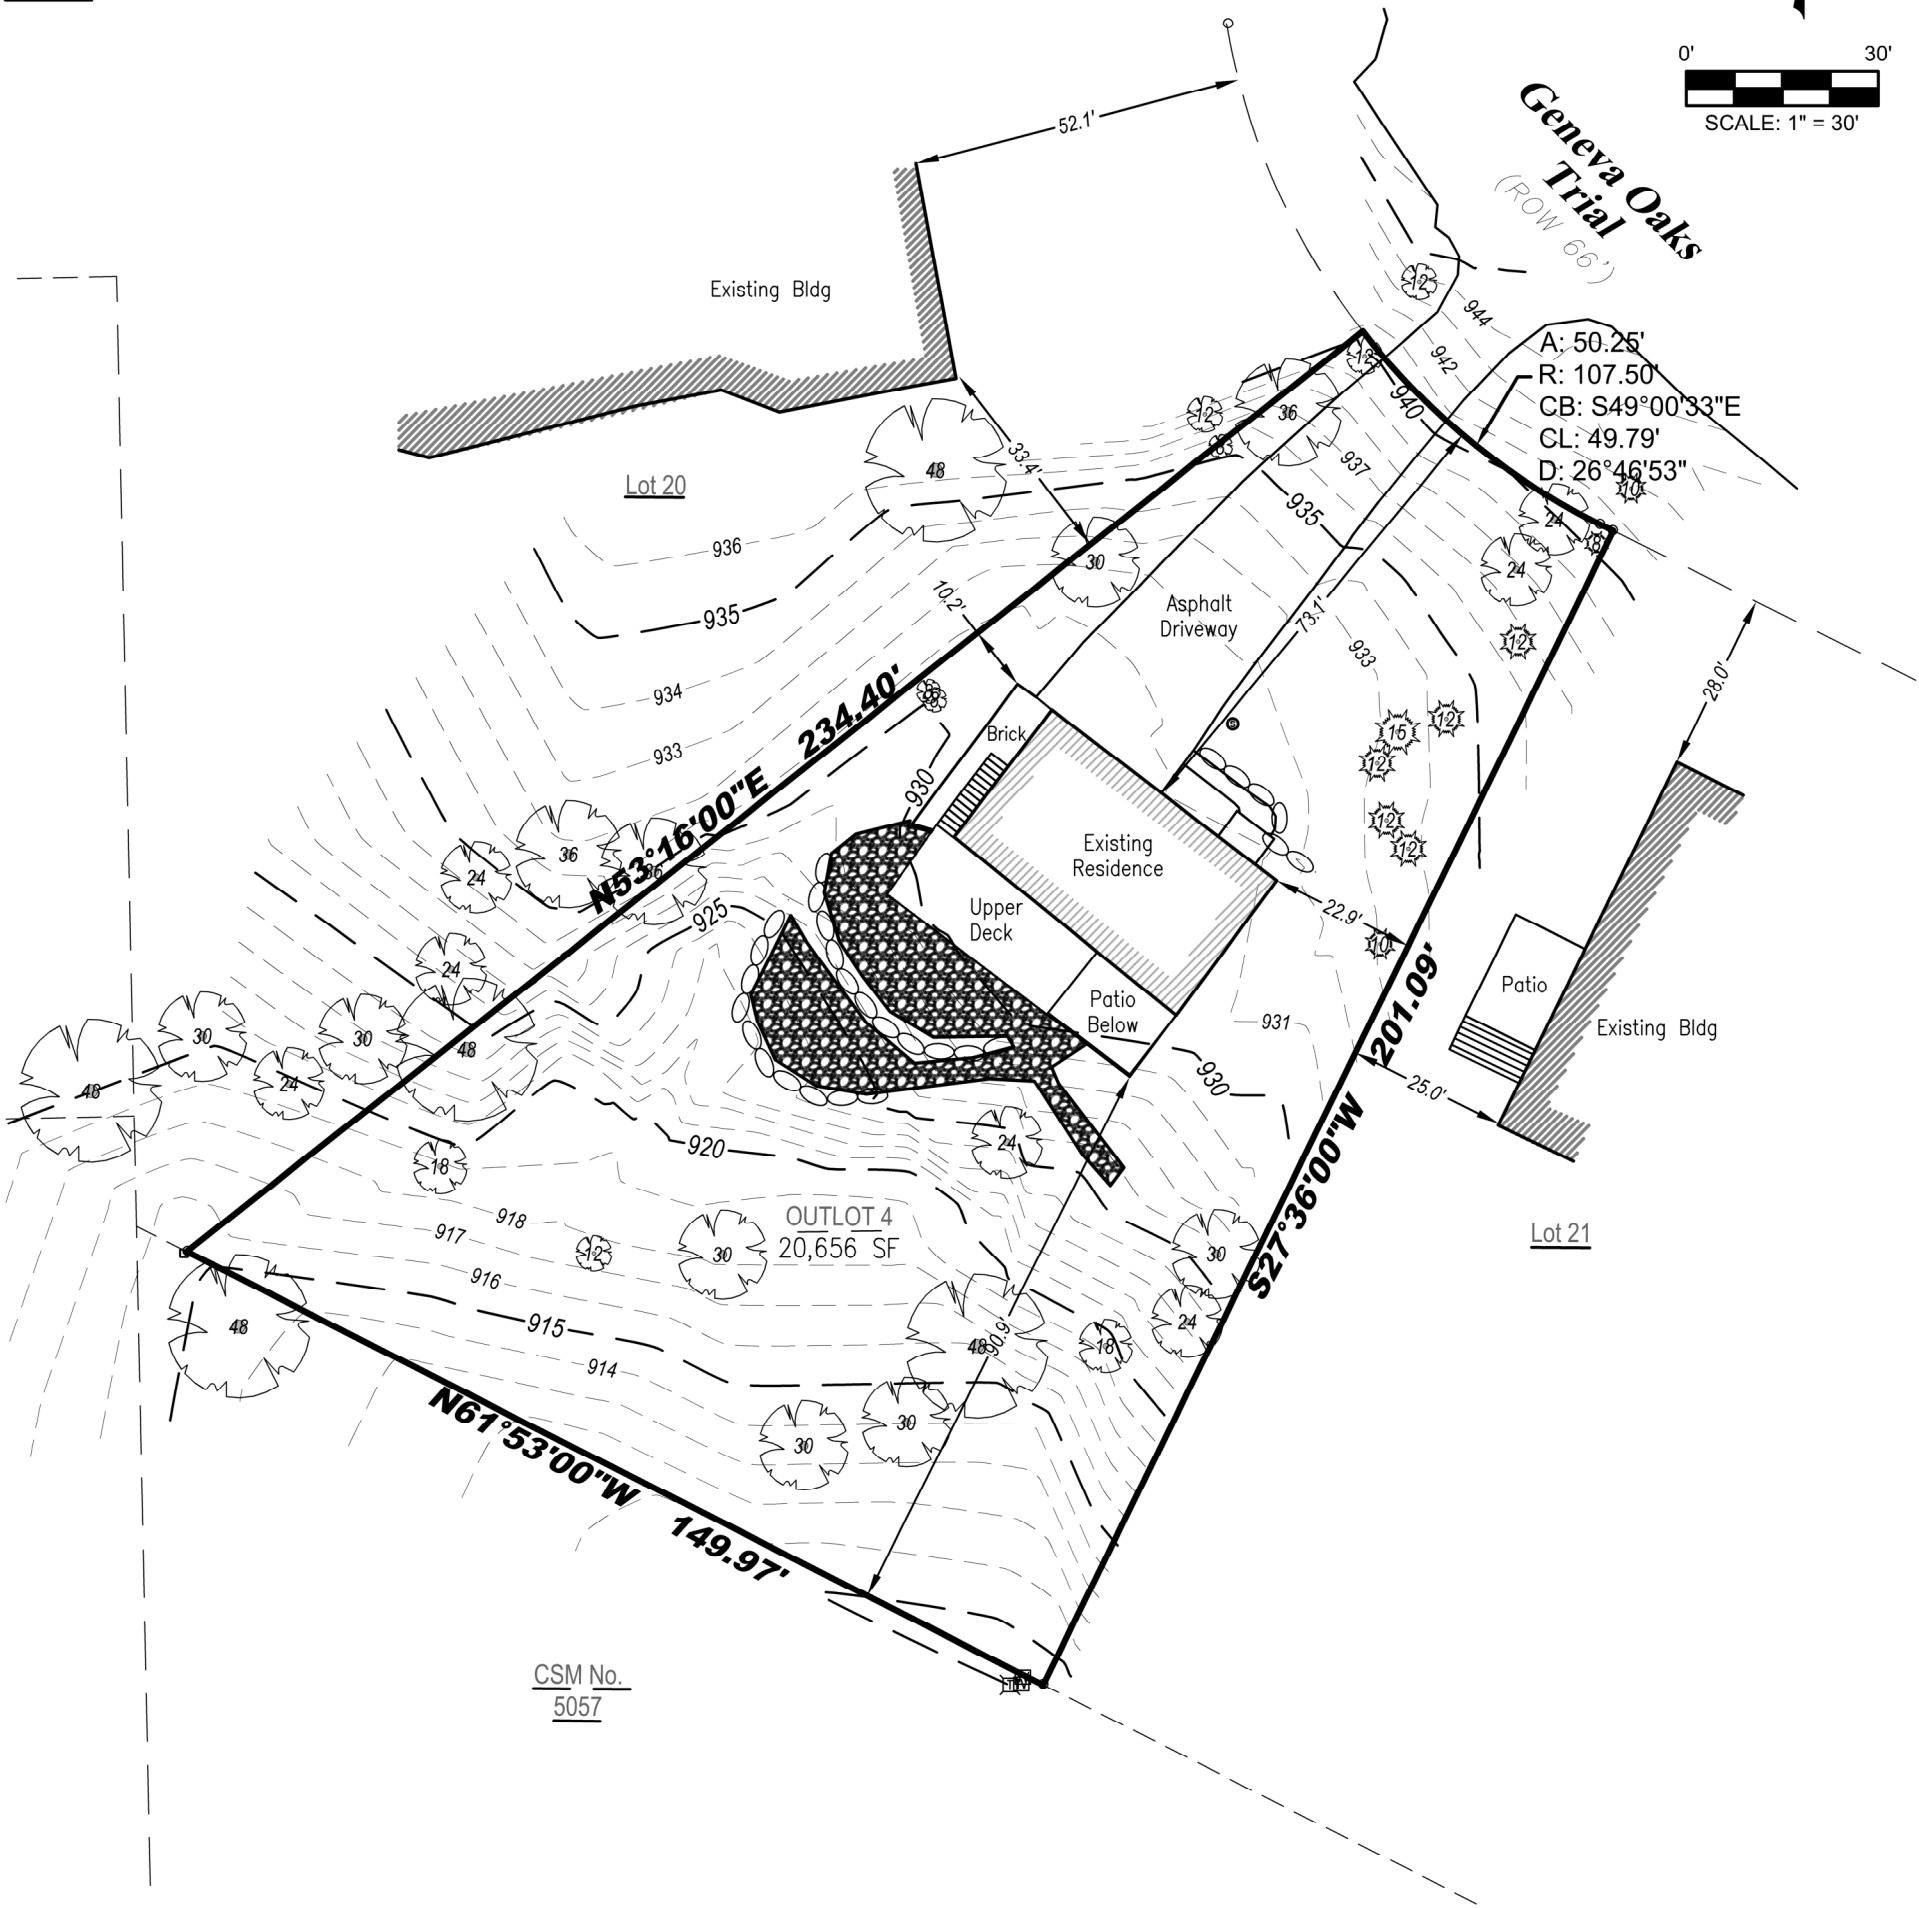

Legend:

- Found Iron Rod
- Found 1" Iron Pipe
- Telephone Pedestal
- TV Pedestal
- Septic Tank Cover
- Coniferous Tree
- Deciduous Tree

**LYNCH & ASSOCIATES**  
ENGINEERING CONSULTANTS, LLC  
5482 S. WESTRIDGE DRIVE  
NEW BERLIN, WI 53151  
440 MILWAUKEE AVENUE  
BURLINGTON, WI 53105  
(262) 402-5040



I certify that I have surveyed the above-described property and in my professional opinion this map is a true representation thereof and is made in accordance with the records of the register of deeds as nearly as practical and that this survey complies with Wisconsin Administrative code AE-7 except for those items waived, if any, and is bound by Wisconsin State Statute 893.37 that defines statute of limitations in regard to surveys. This survey was prepared for the exclusive use of the client and present owners of the property.

No title policy has been provided to the surveyor regarding the property identified on this map. Therefore this plat of survey does not guarantee the existence, size and location of any easements, encumbrances, restrictions or other facts that could otherwise be disclosed in an ALTA/NSPS survey.

  
Rick R. Hillmann, Professional Land Surveyor, S-3005

DRAWING BY:  
FIELD WORK BY: