LOCATION: W4192 Southland Rd, Lake Geneva, WI 53147


PREPARED FOR: Marc Lifshin


PROPERTY DESCRIPTION: (Per Document No.: 918179)

Lot 1 Certified Survey Map No. 4532 as recorded June 23, 2014 in volume 29 of Certified Surveys on page 304 as Document no. 886995, and being part of Government Lot 1 (Northeast $\frac{1}{4}$) of Section 8, T1N, R17E, Town of Linn, Walworth County, Wisconsin.

CURRENT OWNER: ML Ventures LLC

TAX ID: |A453200001

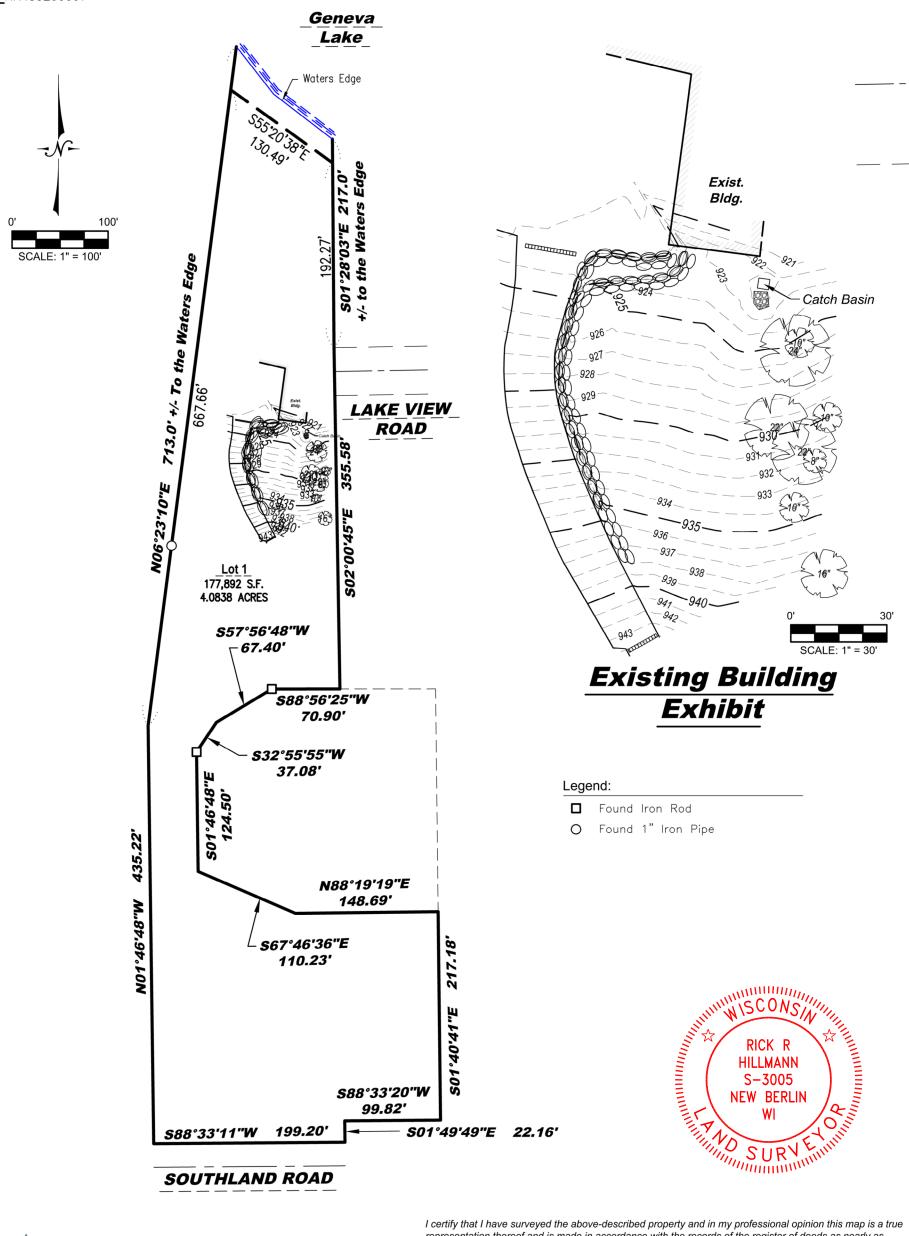

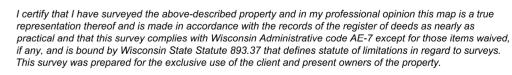

No title policy has been provided to the surveyor regarding the property identified on this map. Therefore this plat of survey does not guarantee the existence, size and location of any easements, encumbrances, restrictions or other facts that could otherwise be disclosed in an ALTA/NSPS survey.



Rick R. Hillmann, Professional Land Surveyor, S-3005

DRAWING BY: FIELD WORK BY:



5482 S. WESTRIDGE DRIVE NEW BERLIN, WI 53151 440 MILWAUKEE AVENUE BURLINGTON, WI 53105 (262) 402-5040