


Plat of Survey

of
Lot 2 of Certified Survey Map No. 4387,
recorded in Vol. 28 of Certified Survey Maps of Walworth County on Page 227 and located in Government Lot 3 in the Southwest 1/4 of Section 11, Town 1 North, Range 17 East, Town of Linn, Walworth County, Wisconsin.


Surveyed for: **Harold B. Smith,**
as Trustee of the 1807 Sidney Smith Lane Trust
200 West Madison Street * Suite 3400
Chicago, Illinois. 60606

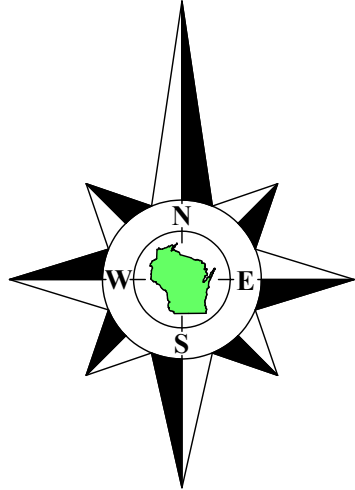

Bearings referenced to the East line of the Southwest 1/4 of Section 11-1-17, recorded as N1°21'19"W 2462.77' in the Wisconsin State Plane Coordinate System, South Zone, (NAD-27).

Coordinates are referenced to the Wisconsin State Plane Coordinate System, South Zone, (NAD-27).

**Lot 2
C.S.M. 4387**
**Tax Parcel
IA438700002**
5.895 Acres
256,776 Sq.Ft.

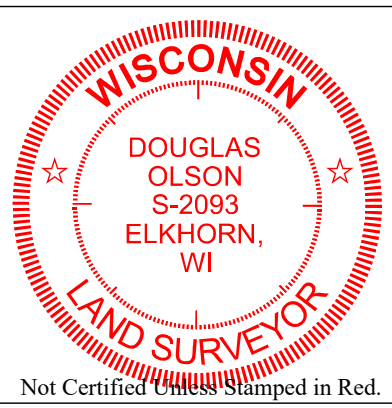

- Notes:**
- 1) This Plat of Survey is not certified unless signed and sealed in red ink.
 - 2) This survey is subject to Wisconsin lien laws. This Plat of Survey is the notice of intent to file lien. Lien waiver required.
 - 3) The Survey Date shown on this Plat of Survey is the completion date of the field work.

Copyright © 2023 by Olson Land Surveying, LLC.

All rights reserved. No part of this survey plat may be reproduced or transmitted in any form by any means - graphic, electronic, or mechanical, including photocopying, tracing, or information storage and retrieval systems - without permission in writing from Douglas G. Olson, Olson Land Surveying, LLC.

I hereby certify that I have surveyed the above described property in compliance with Chapter A-E-7 of the Wisconsin Administrative Code and that the map hereon is correct to the best of my professional knowledge and belief and shows the size and location of the property, its exterior boundaries, the location and dimensions of all visible structures thereon, boundary fences, apparent easements and roadways and visible encroachments, if any.
This survey is made for the exclusive use of the present owners of the property, and also those who purchase, mortgage or guarantee title thereto, within one year from the date hereof.

Douglas G. Olson
Wisconsin Professional Land Surveyor - 2093

South 1/4 Corner
Section 11-1-17.
N. 205.401.57
E. 2,416.524.94