
## HAROLD H. K<del>O</del>LB

REGISTERED PROFESSIONAL LAND SURVEYOR

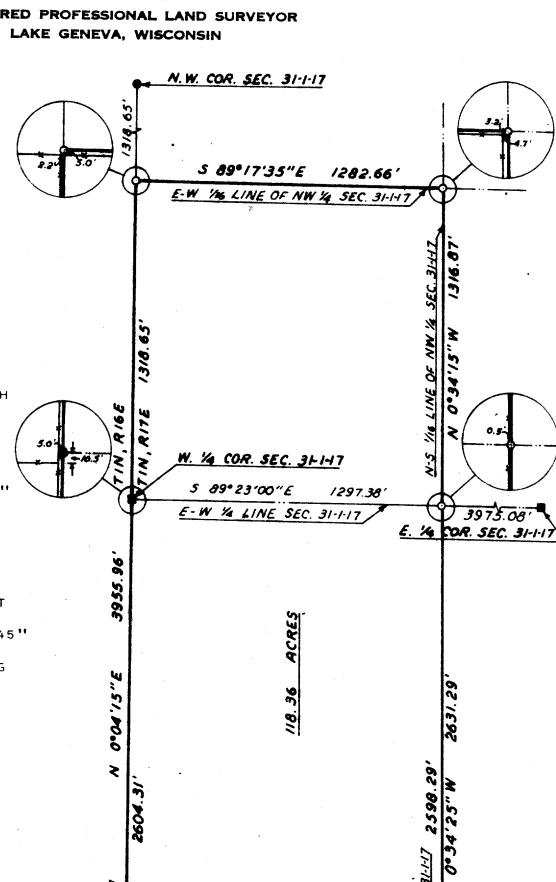

PLAT OF SURVEY OF

A PARCEL OF LAND LOCATED IN THE WEST 1/2 OF SECTION 31, T1N, R17E, WALWORTH COUNTY, WISCONSIN, DESCRIBED AS FOLLOWS: BEGINNING AT THE SOUTHWEST CORNER OF SAID SECTION 31; THENCE N 0°04'15" E 3955.96 FEET TO THE EAST-WEST 1/16 LINE OF THE NORTHWEST 1/4 OF SAID SECTION 31; THENCE S 89°17'35" E 1282.66 FEET ALONG SAID EAST-WEST 1/16 LINE TO THE NORTH-SOUTH 1/16 LINE OF SAID NORTHWEST 1/4; THENCE S 0°34'15" E 1316.87 FEET ALONG SAID NORTH-SOUTH 1/16 LINE; THENCE S 0°34'25" E 2631.29 FEET ALONG THE NORTH-SOUTH 1/16 LINE OF THE SOUTHWEST 1/4 OF SAID SECTION 31 TO THE SOUTH LINE OF SAID SECTION; THENCE N 89°39'45" W 1326.93 FEET ALONG SAID SOUTH LINE TO THE PLACE OF BEGINNING. CONTAINING 118.36 ACRES.

NOTE: BEARINGS ARE ASSUMED FROM EXISTING SURVEY RECORDS.

OWNER: JOHN F DUMALSKI

ACCURACY: DISTANCE ± 0.01'

ANGLES ± 05"

ERROR OF CLOSURE LESS THAN

1/3000



S.W. COR. SEC. 31-1-17

5 89°39'45"E 1326.93 STATE LINE ROAD . 66' WIDE

SCALE:/4400' LEGEND

φ - IRON PIPE FOUND

O - IRON PIPE PLACED

FERRIS MONUMENT

X - SPIKE

■ - 6" SQ. TOP X 9" SQ. BOTTOM X 36" CONCRETE MONUMENT

+ L-31-5 (part of)

I. HAROLD H. KOLB, DO HEREBY CERTIFY THAT I HAVE SURVEYED THE PROPERTY HEREON DESCRIBED ACCORDING TO THE OFFICIAL RECORDS, AND THAT THE PLAT HEREON IS A CORRECT REPRESENTATION OF THE LOT LINES.

HAROLD H. KOLB WISCONSIN REGISTERED LAND SURVEYOR, S-187

DATE Sept. 15. 1975

7326.93