


GEORGE T. DUNHAM
SURVEYING & SUBDIVIDING
DELAVER, WISCONSIN

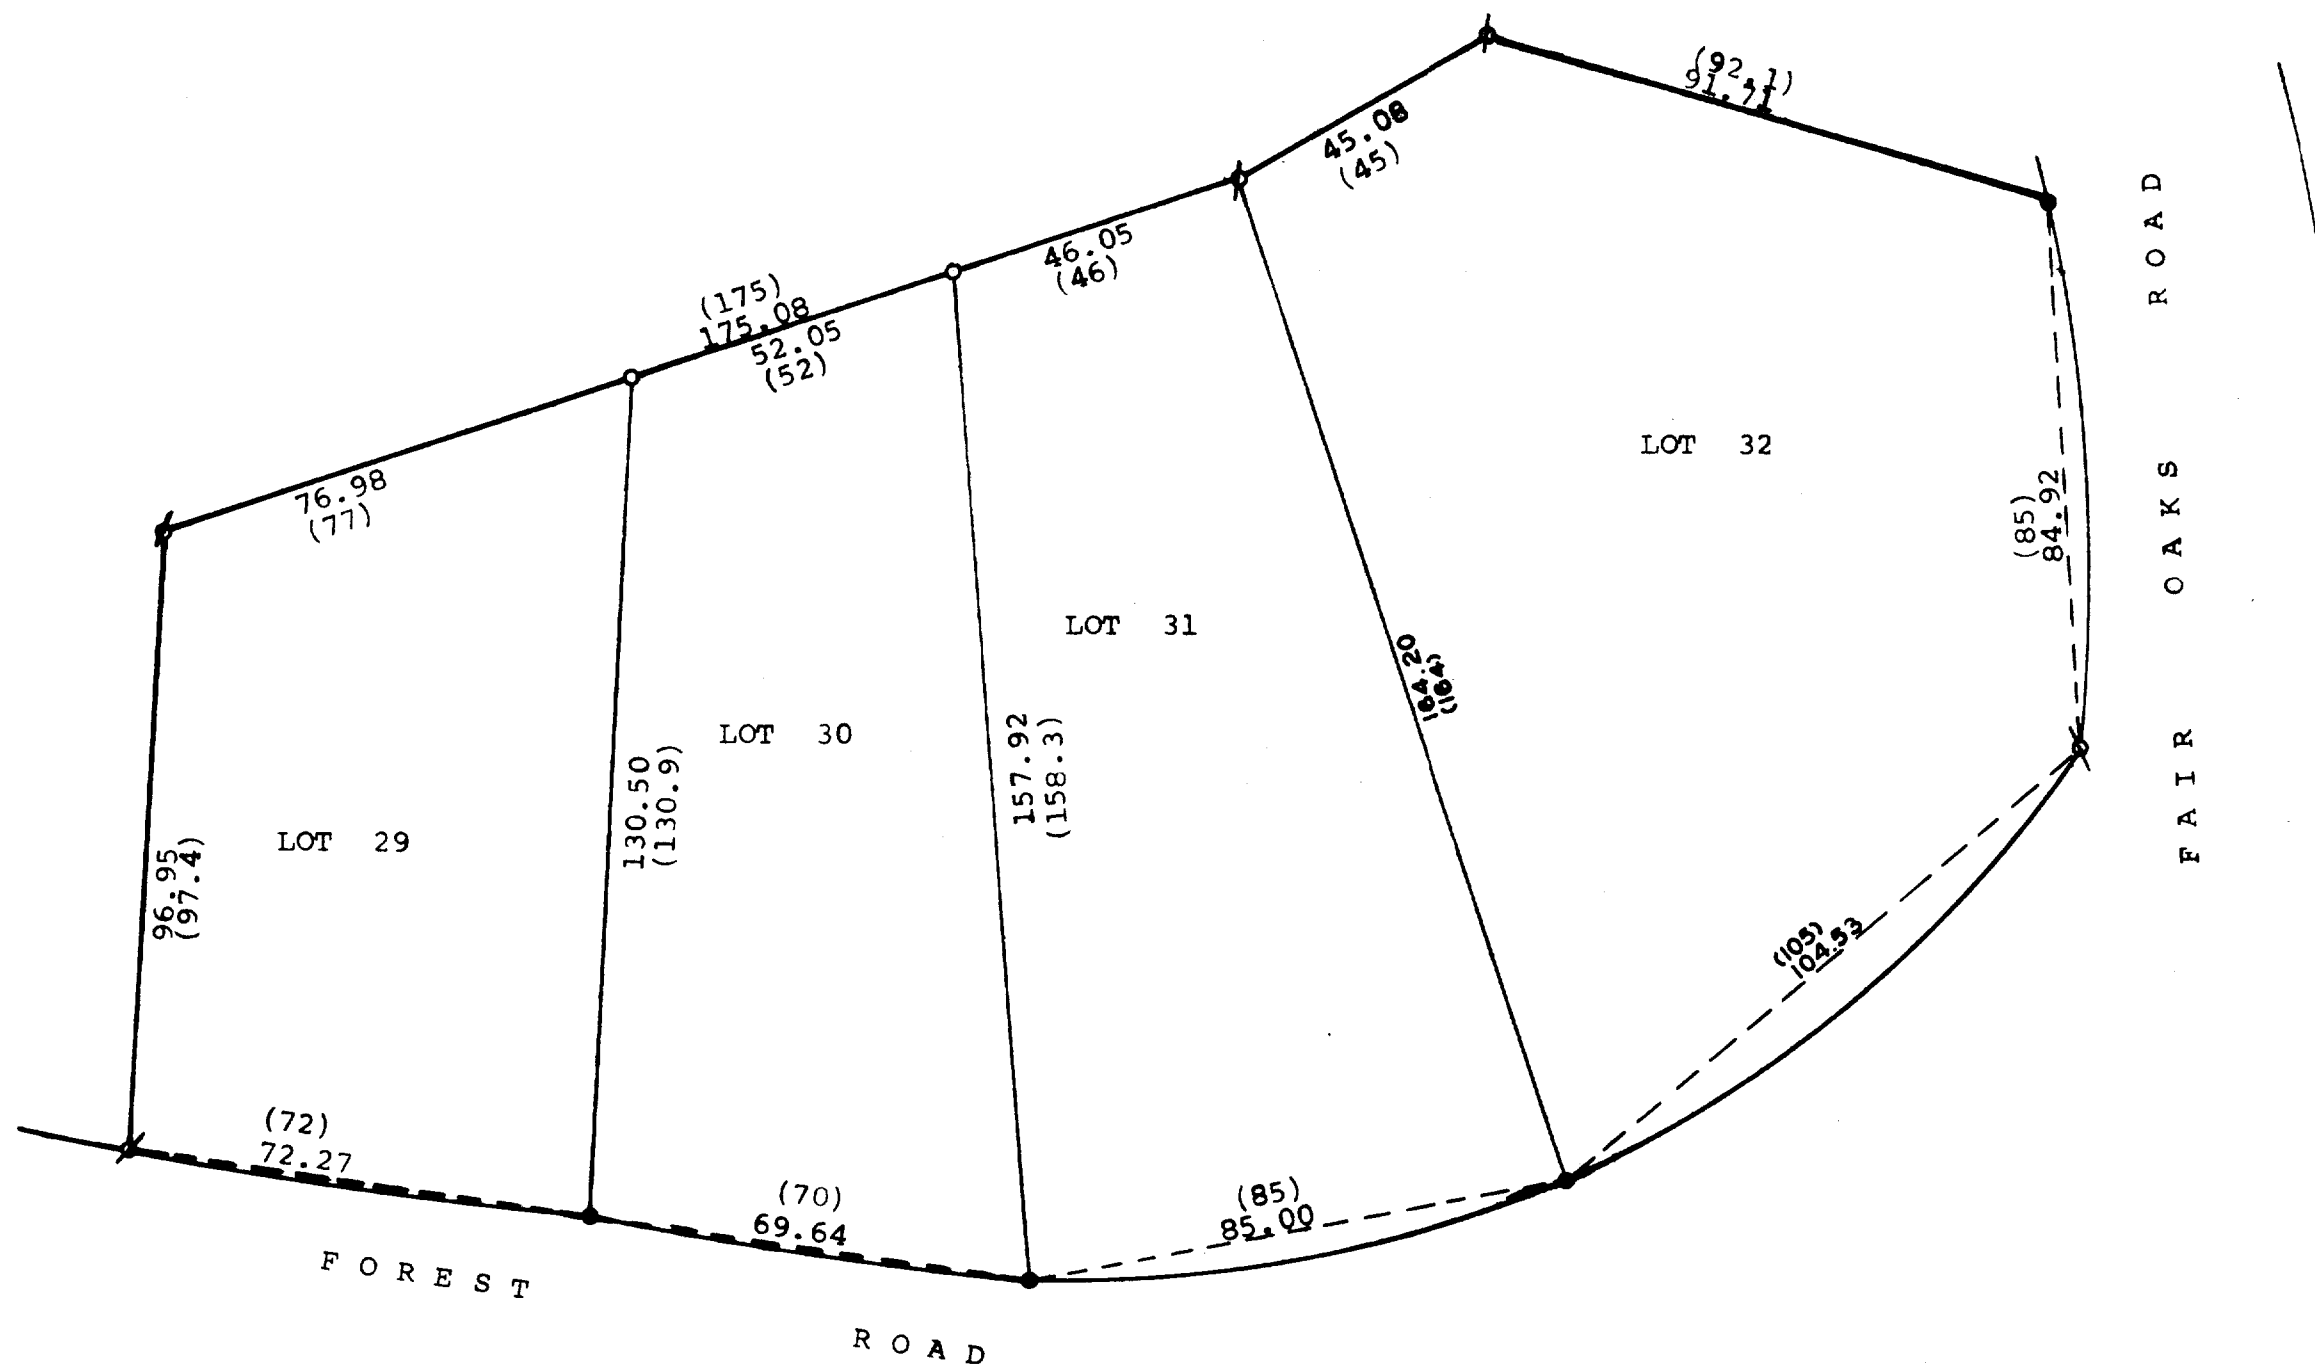


Scale - 1" = 30'
 P = Iron Pipe Found
 O = Iron Pipe Set
 • = Iron Pin Found -
 Iron Pipe Set
 (00) = Distance on Recorded
 Plat

STATE OF WISCONSIN)
 COUNTY OF WALWORTH) SS

I, George T. Dunham, Surveyor, certify that I have surveyed the property described as follows,
 Lots 29-32 inclusive, Block 3 of Wooddale Addition,
 a subdivision located in Section 9, T 1 N, R 17 E,
 Walworth County, Wisconsin,
 and the above map is a true representation thereof and shows the size and location of the property, its exterior boundaries, the location and dimensions of all structures thereon, fences, apparent easements and roadways and visible encroachments, if any.
 This survey is made for the exclusive use of the present owners of the property, and also those who purchase, mortgage, or guarantee the title thereto within one (1) year from date hereof; and as to them I warrant the accuracy of said survey and map.
 October 29, 1975

George T. Dunham
 George T. Dunham, Surveyor

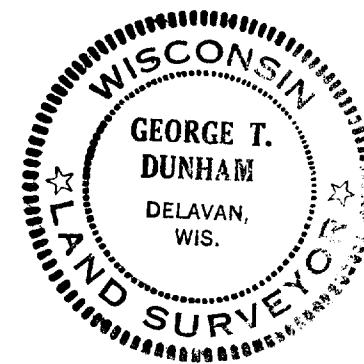

117-489