


PLAT OF SURVEY
-OF-

LOT 31 OF "CAMP SYBIL" A SUBDIVISION LOCATED IN GOVERNMENT LOT 2 IN THE NORTHEAST FRACTIONAL 1/4 OF SECTION 18, TOWNSHIP 1 NORTH, RANGE 17 EAST OF THE FOURTH PRINCIPAL MERIDIAN, IN THE TOWN OF LINN, COUNTY OF WALWORTH AND STATE OF WISCONSIN.

SURVEY FOR: ROBERT BUSCH



SURVEY ADDRESS: N1549 SYBIL LANE, FONTANA, WI 53125

NOTE: REFER TO A CURRENT TITLE REPORT FOR EASEMENTS, RESTRICTIONS OR COVENANTS WHICH MAY AFFECT THIS PROPERTY.

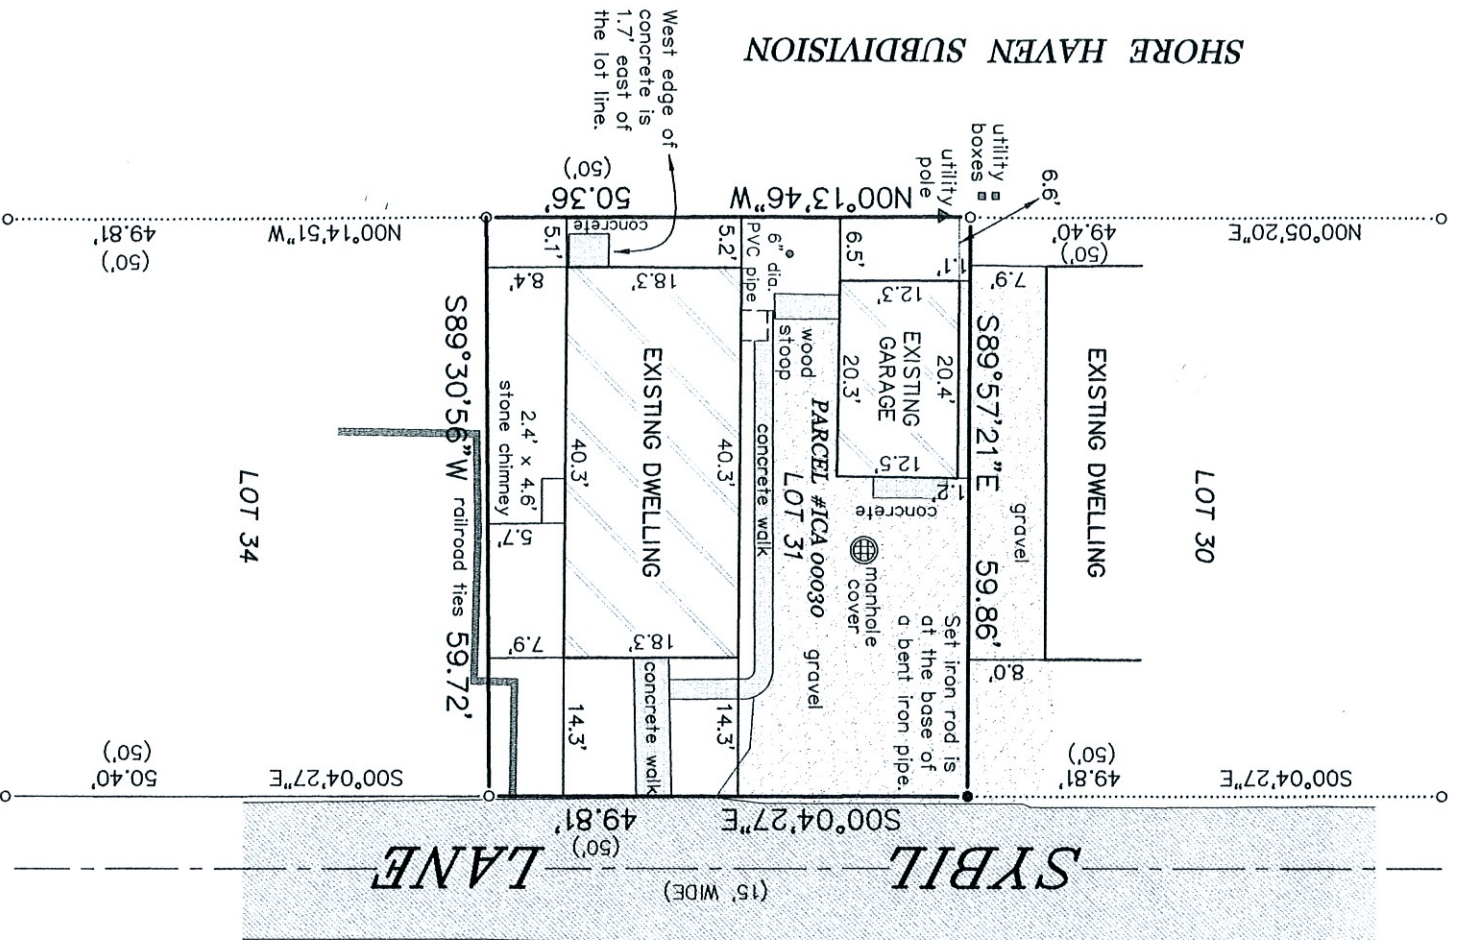

- LEGEND**
- FOUND IRON PIPE
 - SET IRON ROD
 - () RECORDED AS

BEARINGS HEREON RELATE TO THE EAST LINE OF LOTS 30, 31 AND 34 OF "CAMP SYBIL". ASSUMED BEARING OF SOUTH 00°04'27" EAST.

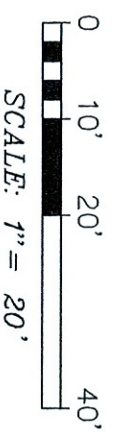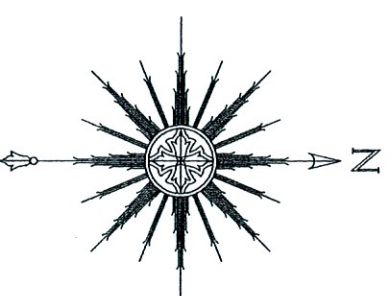

NOTE: THE PROPERTY CORNERS FOR THE SUBDIVISION LOTS SHOULD THEORETICALLY BE IN A STRAIGHT LINE ON THE EAST AND WEST PROPERTY LINES. THE FOUND PROPERTY CORNER MONUMENTS THROUGHOUT THE SUBDIVISION REVEAL INCONSISTENCIES WITH PLATTED MEASUREMENTS. THE FOUND IRON STAKES (MANY OF WHICH HAVE ANCIENT CHARACTERISTICS) WERE ACCEPTED AS THE BEST EVIDENCE OF THE PROPERTY LINES.

"I HEREBY CERTIFY THAT I HAVE SURVEYED THE ABOVE DESCRIBED PROPERTY AND THAT THE ABOVE MAP IS A CORRECT REPRESENTATION THEREOF AND SHOWS THE SIZE AND LOCATION OF THE PROPERTY, ITS EXTERIOR BOUNDARIES, THE LOCATION OF ALL VISIBLE STRUCTURES AND DIMENSIONS OF ALL PRINCIPAL BUILDINGS THEREON, BOUNDARY FENCES, APPARENT EASEMENTS, ROADWAYS AND ENCROACHMENTS, IF ANY."

"THIS SURVEY IS MADE FOR THE USE OF THE PRESENT OWNERS OF THE PROPERTY, AND THOSE WHO PURCHASE, MORTGAGE, OR GUARANTEE THE TITLE THERETO WITHIN ONE YEAR FROM DATE HEREOF."

THIS IS NOT AN ORIGINAL PRINT
UNLESS THIS SEAL IS RED.



SATTER SURVEYING, LLC
LAND SURVEYS, MAPPING AND PLANNING
272 ORIGIN STREET
BURLINGTON, WI 53105
262-661-4239

THOMAS L. SATTER S-2850
Thomas L. Satter
OCTOBER 4, 2023 092306
DATE JOB NUMBER