LOCATION: N2262 Chapin Road

Lake Geneva, Wisconsin

PREPARED FOR: ELITE PIERS

PROPERTY DESCRIPTION:

BEING PART OF LOT 7 OF S.B. CHAPIN'S SUBDIVIS

 
BEING PART OF LOT 7 OF S.B. CHAPIN'S SUBDIVISION,
BEING PART OF THE NORTHEAST 1/4 AND THE
SOUTHEAST 1/4 OF SOUTHWEST 1/4 OF THE
NORTHWEST1/4 OF SECTION 4, TOWN 1 NORTH, RANGE 17
EAST OF THE FOURTH PRINCIPAL MERIDIAN, LOCATED IN
THE TOWN OF LINN, WALWORTH COUNTY, WISCONSIN.




I certify that I have surveyed the above-described property and in my professional opinion this map is a correct representation thereof and is made in accordance with the records of the register of deeds as nearly as practical and that this survey complies with Wisconsin Administrative code AE-7 except for those items waived, if any, and is bound by Wisconsin State Statute 893.37 that defines statute of limitations in regard to surveys. This survey was prepared for the exclusive use of the client and present owners of the property.

No title policy has been provided to the surveyor regarding the property identified on this map. Therefore this plat of survey does not guarantee the existence, size and location of any easements, encumbrances, restrictions or other facts that could otherwise be disclosed in an ALTA/NSPS survey.

Ritchie P. Wenzel, Professional Land Surveyor, S-4027



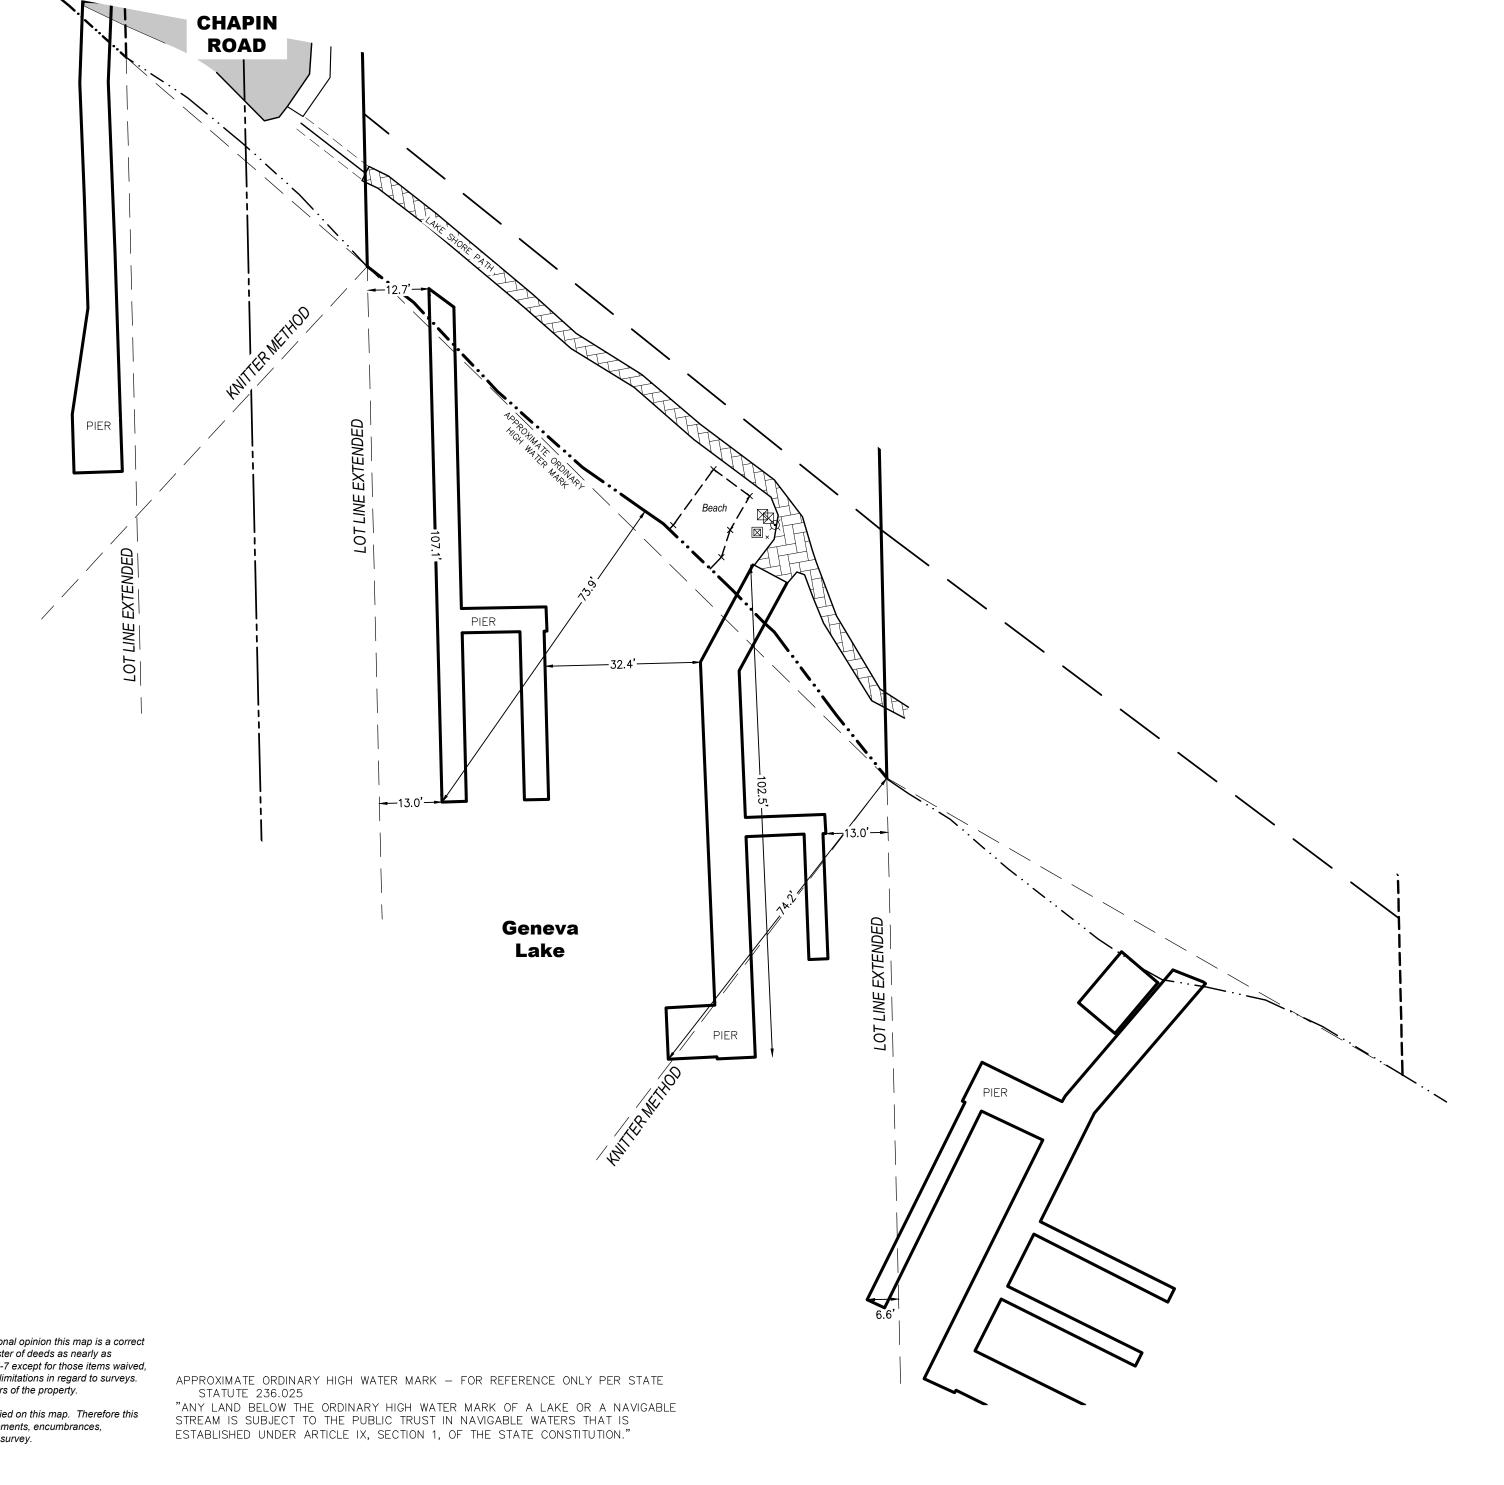

Survey No. 25.5025.01

