


GEORGE T. DUNHAM
SURVEYOR & ENGINEER
DELAWARE, WISCONSIN

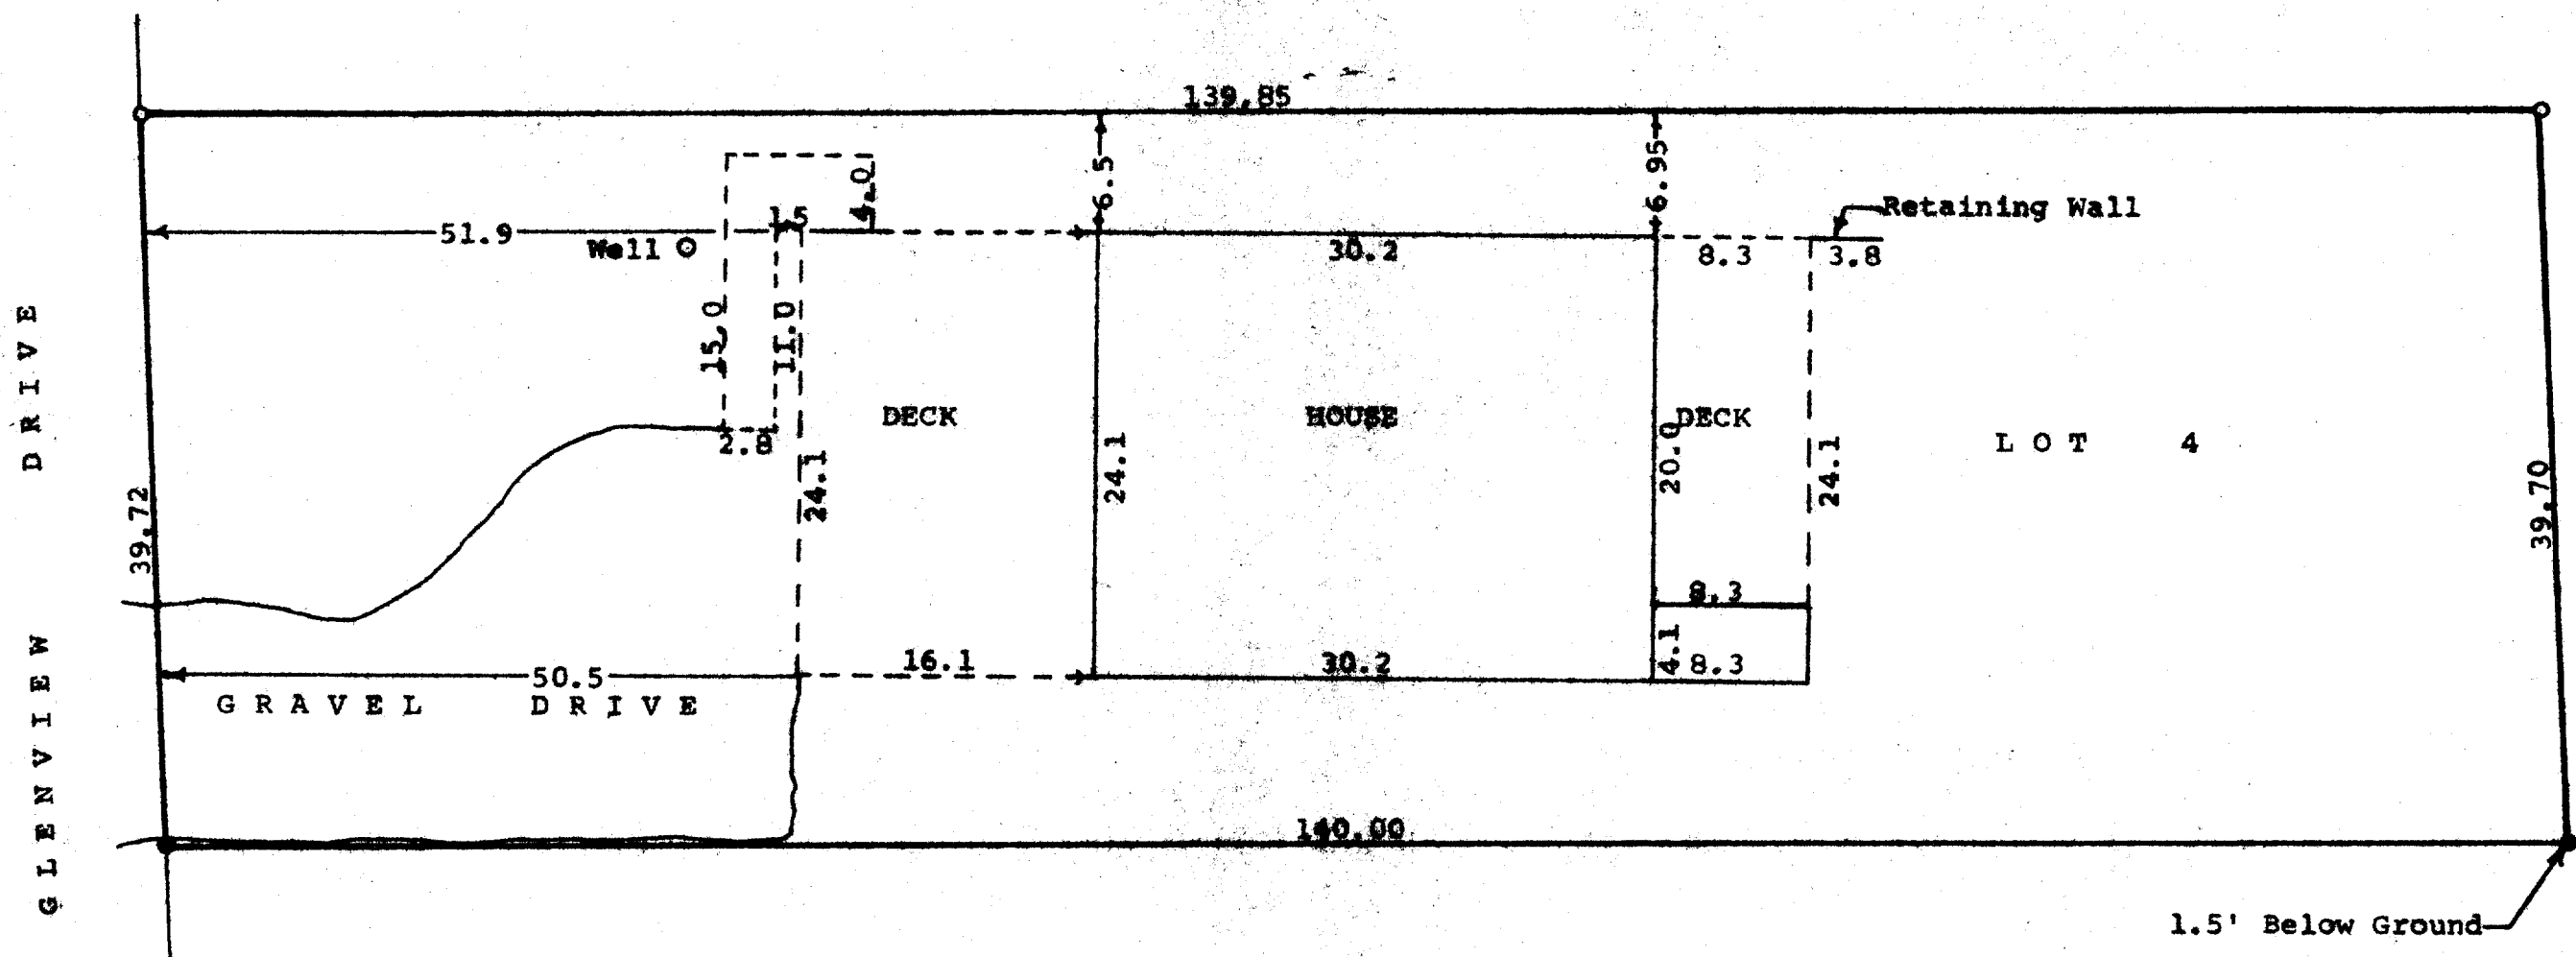

STATE OF WISCONSIN)
COUNTY OF WALWORTH) ss

I, George T. Dunham, Surveyor, certify that I have surveyed the property described as follows,

Lot 4, Block "E" of Cisco Beach, a subdivision located in Section 5, T 1 N, R 17 E, Walworth County, Wisconsin,

and the above map is a true representation thereof and shows the size and location of the property, its exterior boundaries, the location and dimensions of all structures thereon, fences, apparent easements and roadways and visible encroachments, if any.

This survey is made for the exclusive use of the present owners of the property, and also those who purchase, mortgage, or guarantee the title thereto within one (1) year from date hereof, and as to them I warrant the accuracy of said survey and map.
September 24, 1976

George T. Dunham
George T. Dunham, Surveyor

Scale - 1" = 10'

o = Iron Pipe Found

• = Concrete Monument Found

NOTE: According to the Zoning Ordinance, Walworth County, Wisconsin, Section 7.2; existing structure is not in violation of present side yard requirements.

