

PLAT OF SURVEY
OF



Lots 7 and 8, Block 5, Geneva, a subdivision located in the SW^{1/4} of the SW^{1/4} of Section 10, TIN RIVE, Walworth County, Wisconsin.

April 18, 1972

Surveyed for: Properties Unlimited -- John J. Donahue

I certify that I have surveyed the above inscribed property and that the plat shown herein is an accurate survey and a true representation thereof and correctly shows the boundary lines of said property.

LINWOOD AVE.
50' WIDE

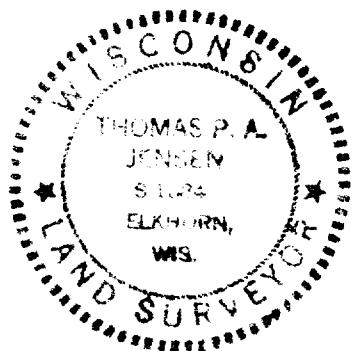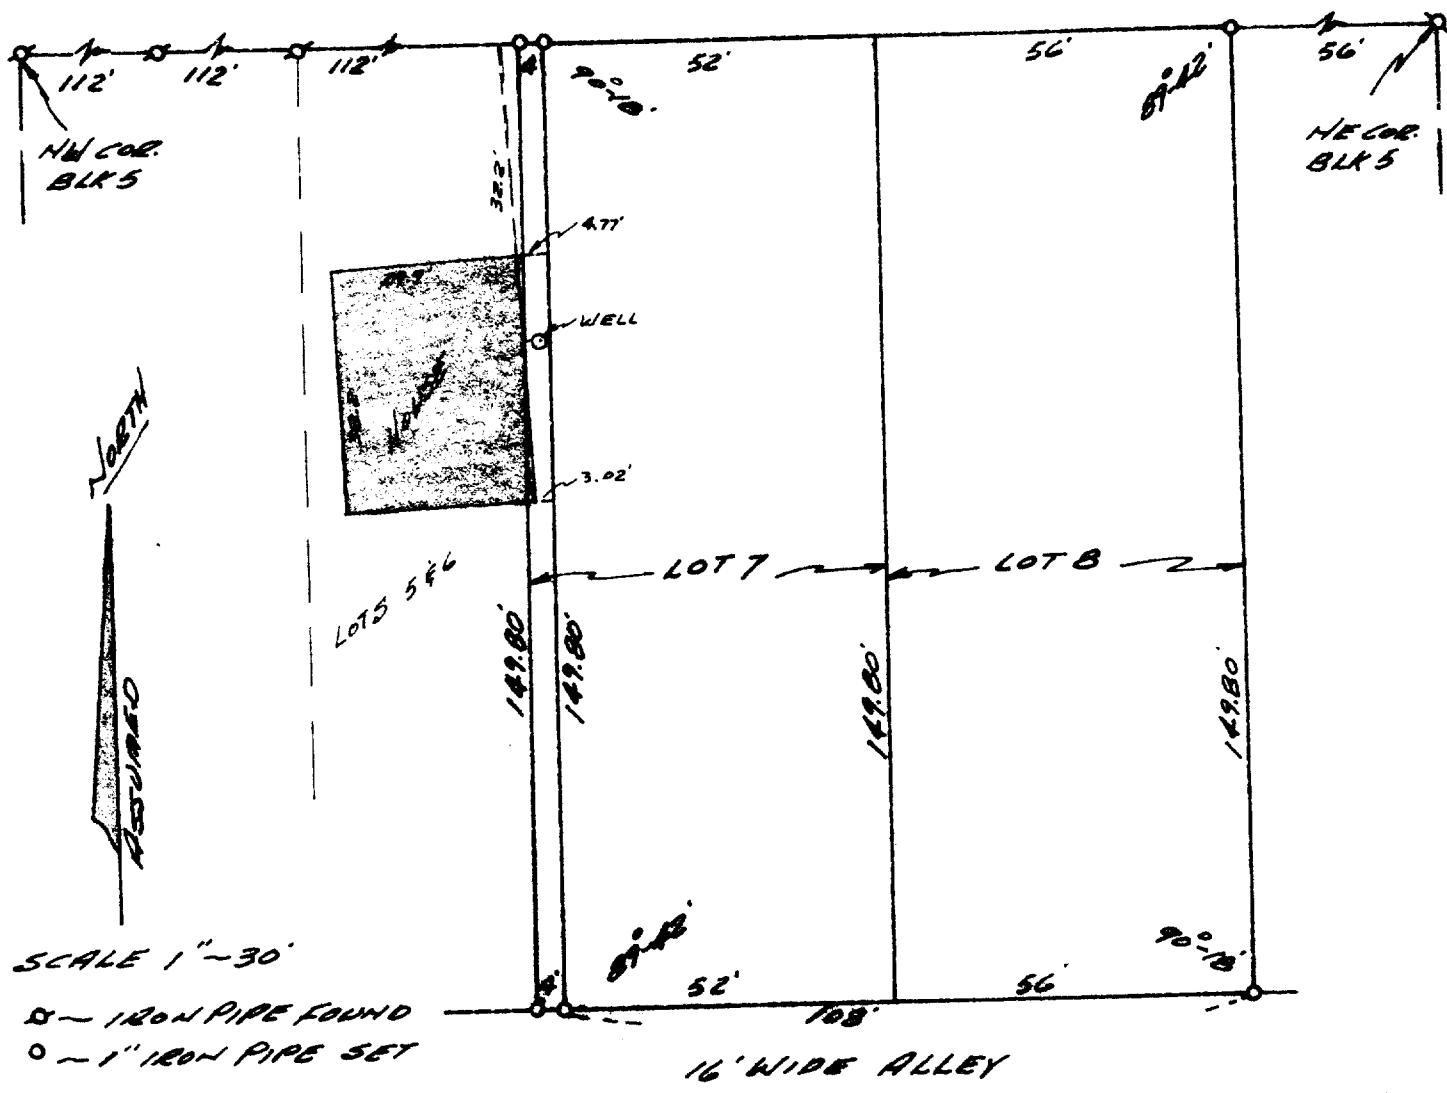

Thomas P.A. Jensen
Thomas P.A. Jensen S-1084
Jensen Surveying & mapping
ELKHORN, WISCONSIN

117-550 ✓