


HAROLD H. KOLB

REGISTERED PROFESSIONAL LAND SURVEYOR
LAKE GENEVA, WISCONSIN

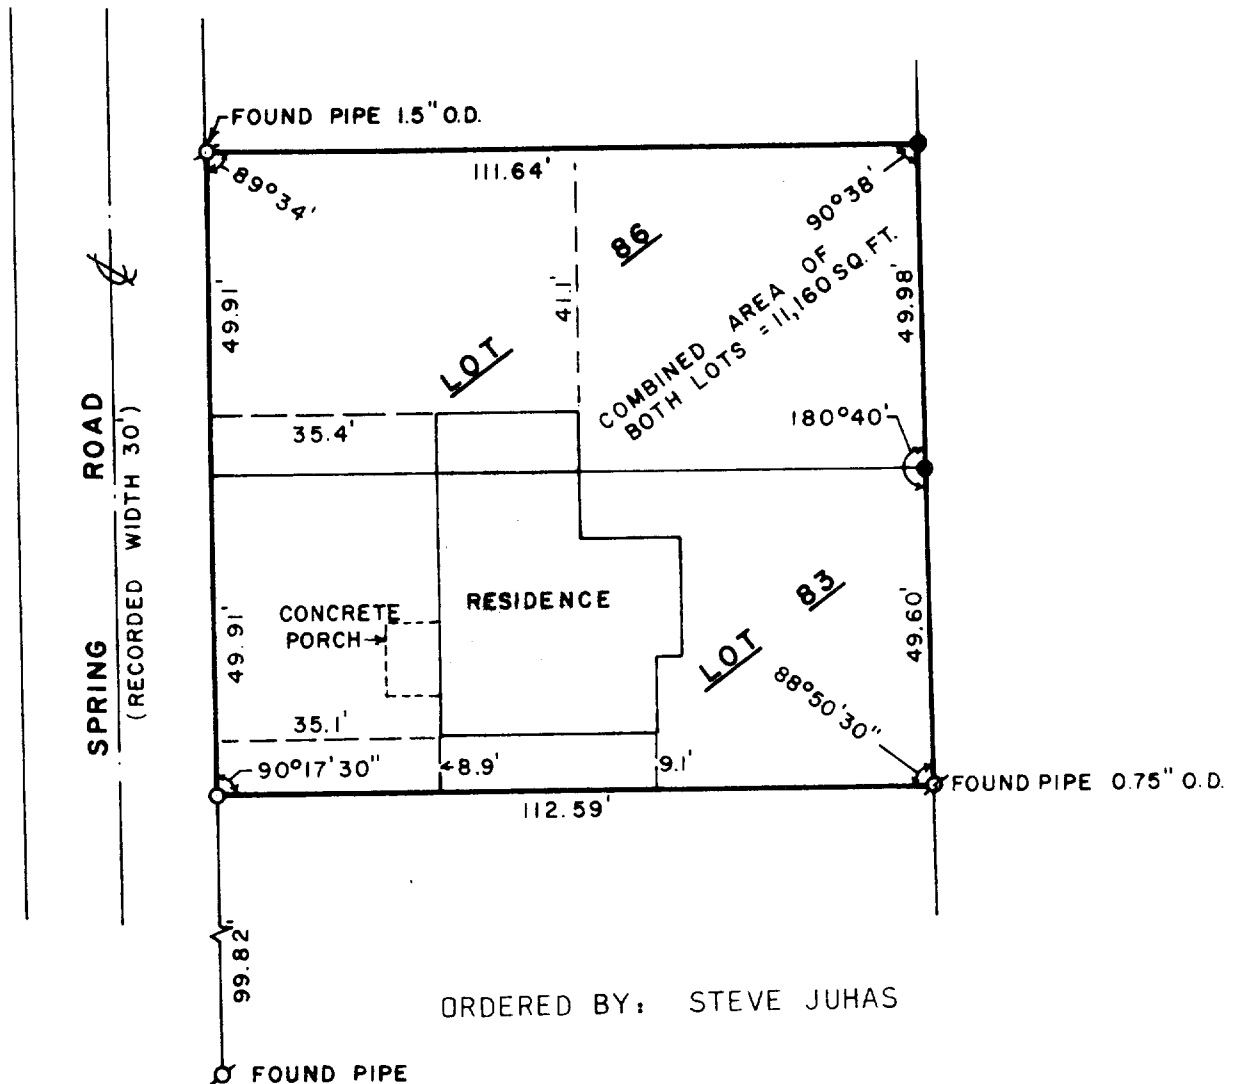


PLAT OF SURVEY OF

LOTS 83 AND 86, LAKE GENEVA BEACH SUBDIVISION
LOCATED IN THE SOUTHWEST 1/4 OF SECTION 11,
T 1 N, R 17 E, WALWORTH COUNTY, WISCONSIN.

NOTE: LOTS ORIGINALLY PLATTED AS 50' X 112 1/2'.

ACCURACY: DISTANCES $\pm 0.01'$
ANGLES $\pm 30''$

RATIO OF ERROR--LESS THAN ONE
PART IN 3000

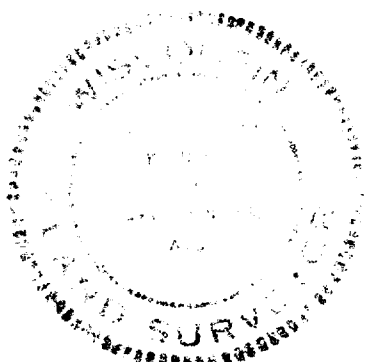

N



SCALE: 1"=30'

LEGEND

- O — IRON PIPE PLACED, 1 1/2" x 24" 1.13 LB./LIN. FT.
- — CONCRETE MONUMENT, 5" DIA. — FOUND

I, HAROLD H. KOLB, do hereby certify that I HAVE
SURVEYED THE ABOVE PROPERTY AND THE SAME IS ACCORDING
TO THE BEST OF MY KNOWLEDGE AND BELIEF A CORRECT
AND TRUE PLAT OF THE SAME.

Harold H. Kolb

HAROLD H. KOLB
WISCONSIN REGISTERED LAND SURVEYOR, S-187
DATE April 22, 1977

117-552