
DUNHAM SURVEYING, S.C. SURVEYING & SUBDIVIDING DELAYAN, WISCONSIN 53115

K & E 10-9185 250-9-74

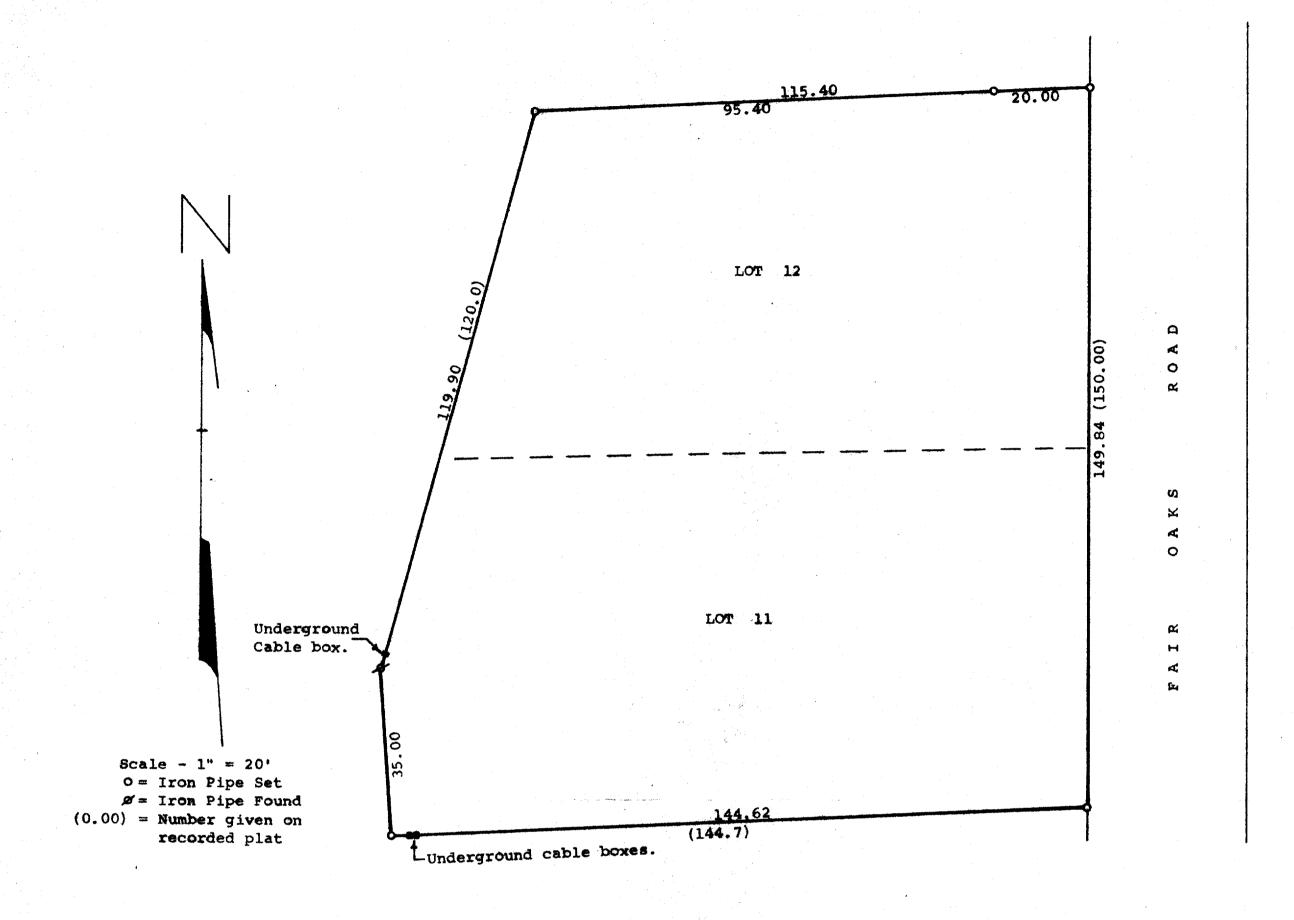

STATE OF WISCONSIN) COUNTY OF WALMORTH) SS

I, James M. Dunham, Surveyor, certify that I have surveyed the property described as follows,

Lots 11 and 12. Block 10 of Wooddale Addition, a subdivision located in the Southwest 4 of Fractional Section 9, and in Section 16, TIM, RITE, Walworth County, Wisconsin.

and the above map is a true representation thereof and shows the size and location of the property, its exterior boundaries, the location and dimensions of all structures thereon, fences, apparent easements and roadways and visible encroachments, if any.

This survey is made for the exclusive use of the present owners of the property, and also those who purchase, mortgage, or guarantee the title thereto within one (1) year from date hereof; and as to them I warrant the accuracy of said survey and map.

April 25, 1977

James M. Dunham, Surveyor

