
PLAT OF SURVEY

ORIOLE

LANE

OF LOT 9 OF BLOCK A OF CISCO BEACH SUBDIVISION, TOWN OF LINN, WALWORTH COUNTY, WISCONSIN.

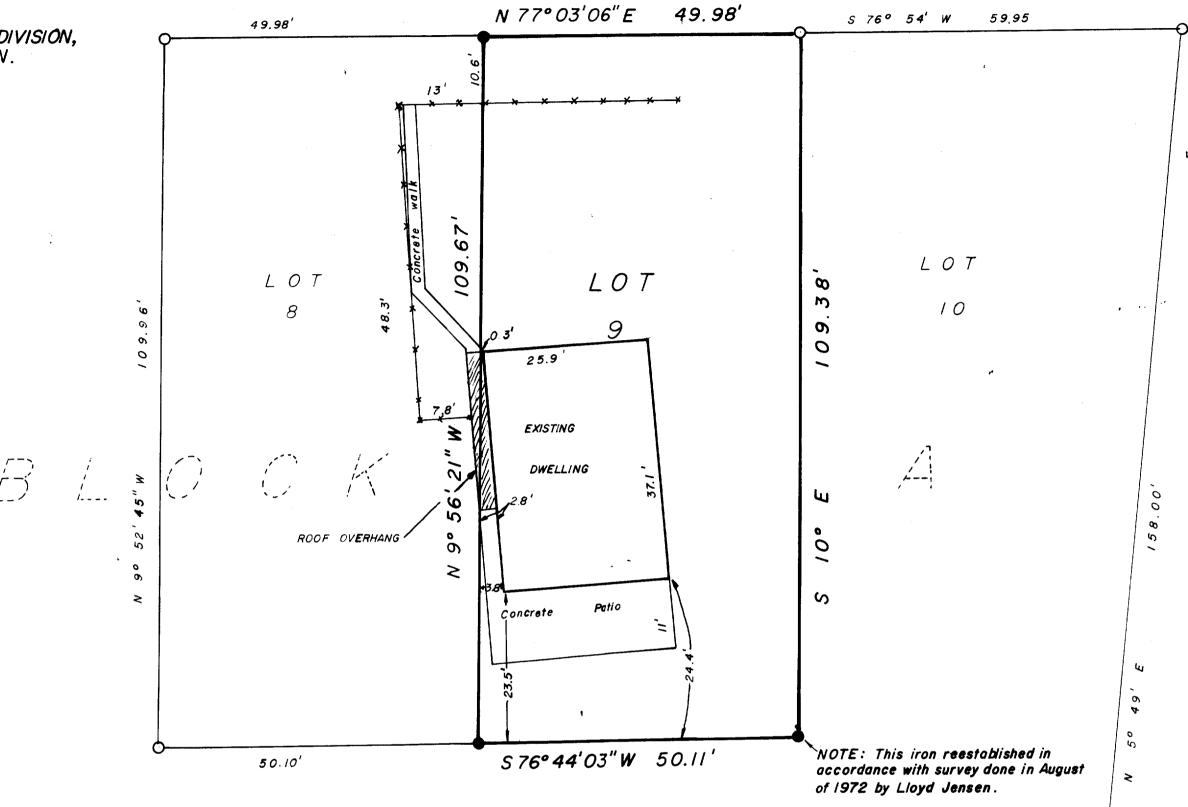


Bearings Referenced to East line of Property, Previously Platted as S 10°E.

L E G E N D

O- IRON PIPE FOUND

●-IRON BAR SET 3/4"X30" 1.50 LB/FT.

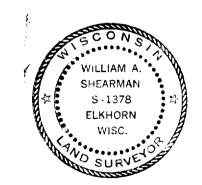

Surveyors Certificate

I CI-8

I, William A. Shearman, Registered Land Surveyor, do hereby certify that the plat shown hereon is a true and accurate survey and a true representation thereof and the exterior boundary lines and all divisions of said property have been surveyed under my direction and to the best of my knowledge and belief.

William A. Shearman S-1378

Registered Land Surveyor

JENSEN & JOHNSON

ENGINEERS AND SURVEYORS PO BOX 290, ELKHORN, WISCONSIN 414-723-3204

A Division of

Donohue & Associates, Inc.

Date	Scale
DE C . 20,1977	" = 5'
Drawn By	Surveyed For Scott French
Checked By	Project No.
DAN COOPER	1658.248