

# KOLB LAND CONSULTING, INC.

LAND SURVEYING • SUBDIVIDING • LAND PLANNING

LAKE GENEVA, WISCONSIN 53147

WHITEWATER, WISCONSIN 53190

## PLAT OF SURVEY OF

LOT 5, BLOCK 1, TRINKE ESTATES  
SUBDIVISION, TOWN 1 NORTH, 17  
RANGE 18 EAST, WALWORTH COUNTY,  
WISCONSIN.

I HEREBY CERTIFY THAT I HAVE SURVEYED THE  
ABOVE DESCRIBED PROPERTY AND THAT THE ABOVE  
MAP IS A TRUE REPRESENTATION THEREOF AND SHOWS  
THE SIZE AND LOCATION OF THE PROPERTY, ITS  
EXTERIOR BOUNDARIES, THE LOCATION OF ALL  
VISIBLE STRUCTURES AND DIMENSIONS OF ALL  
PRINCIPAL BUILDINGS THEREON, BOUNDARY FENCES,  
APPARENT EASEMENTS, ROADWAYS AND VISIBLE  
ENCROACHMENTS, IF ANY.


THIS SURVEY IS MADE FOR THE USE OF THE PRESENT  
OWNERS OF THE PROPERTY, AND ALSO THOSE WHO  
PURCHASE, MORTGAGE, OR GUARANTEE THE TITLE  
THERE TO WITHIN ONE (1) YEAR FROM DATE HEREOF.

*Harold H. Kolb*


HAROLD H. KOLB  
WISCONSIN REGISTERED LAND SURVEYOR, S-187

DATE Aug 7, 1980 4

ORDERED BY:  
KEEFE REAL ESTATE, INC.  
704 MAIN STREET  
LAKE GENEVA, WI 53147

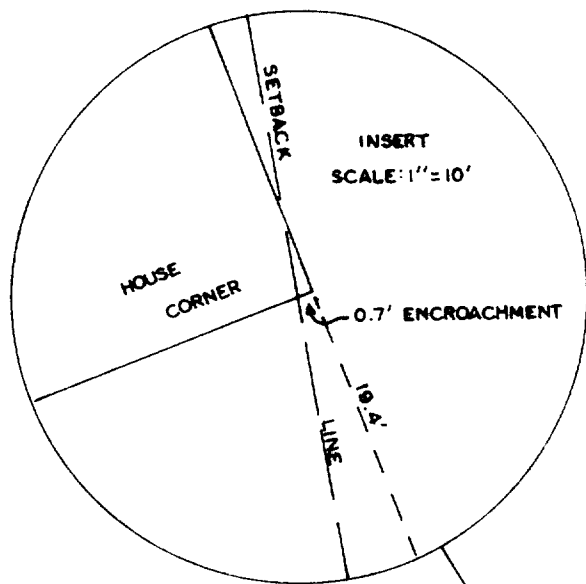

NOTE: IRON PIPE IS 0.35'  
EAST OF CORNER.

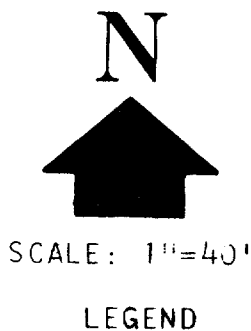

- σ - IRON PIPE FOUND
- ( ) - RECORDED AS
- - LIGHT
- Δ - ANTENNA MAST
- - AIR CONDITIONING UNIT
- - GAS METER
- - WELL

