
KOLB LAND CONSULTING, INC.

LAND SURVEYING . SUBDIVIDING . LAND PLANNING

LAKE GENEVA, WISCONSIN 53147

WHITEWATER, WISCONSIN 53190

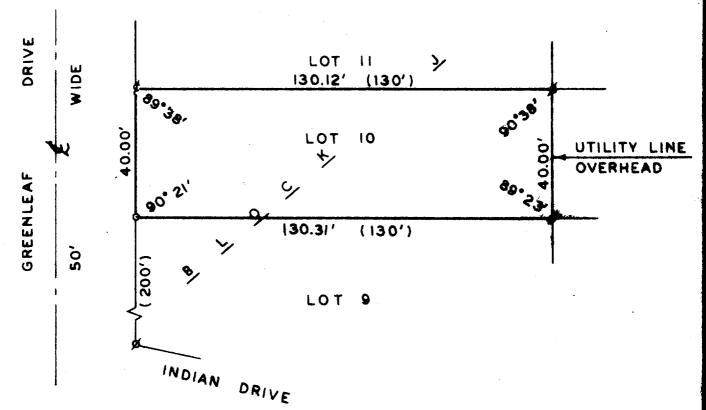

PLAT OF SURVEY OF

LOT 10, BLOCK J, CISCO BEACH SUBDIVISION, TOWN 1 NORTH, RANGE 17 EAST, WALWORTH COUNTY, WISCONSIN.

OWNER: MRS. EUGENE WARD

ORDERED BY. RICHARD P. BRUGGER LAKE GENEVA, WI 53147

I HEREBY CERTIFY THAT I HAVE SURVEYED THE

I HEREBY CERTIFY THAT I HAVE SURVEYED THE ABOVE DESCRIBED PROPERTY AND THAT THE ABOVE MAP IS A TRUE REPRESENTATION THEREOF AND SHOWS THE SIZE AND LOCATION OF THE PROPERTY, ITS EXTERIOR BOUNDARIES, THE LOCATION OF ALL VISIBLE STRUCTURES AND DIMENSIONS OF ALL PRINCIPAL BUILDINGS THEREON, BOUNDARY FENCES, APPARENT EASEMENTS, ROADWAYS AND VISIBLE ENCROACHMENTS, IF ANY.

THIS SURVEY IS MADE FOR THE USE OF THE PRESENT OWNERS OF THE PROPERTY, AND ALSO THOSE WHO PURCHASE, MORTGAGE OR GUARANTEE THE TITLE THERETO WITHIN ONE (1) YEAR FROM DATE HEREOF.

KOLB
S-187
LAKE GENEVA,
WIS.

AROLD H

SCALE: 1"= 30"

LEGEND

#-IRON PIPE FOUND F-POSEY PIN FOUND-IRON PIPE SET O-IRON PIPE SET ()-PLATTED AS

Harold H, Will

HAROLD H. KOLB WISCONSIN REGISTERED LAND SURVEYOR, \$-187

DATE MAY 12, 1980

C&6-12I