


WHITEWATER, WISCONSIN 53190

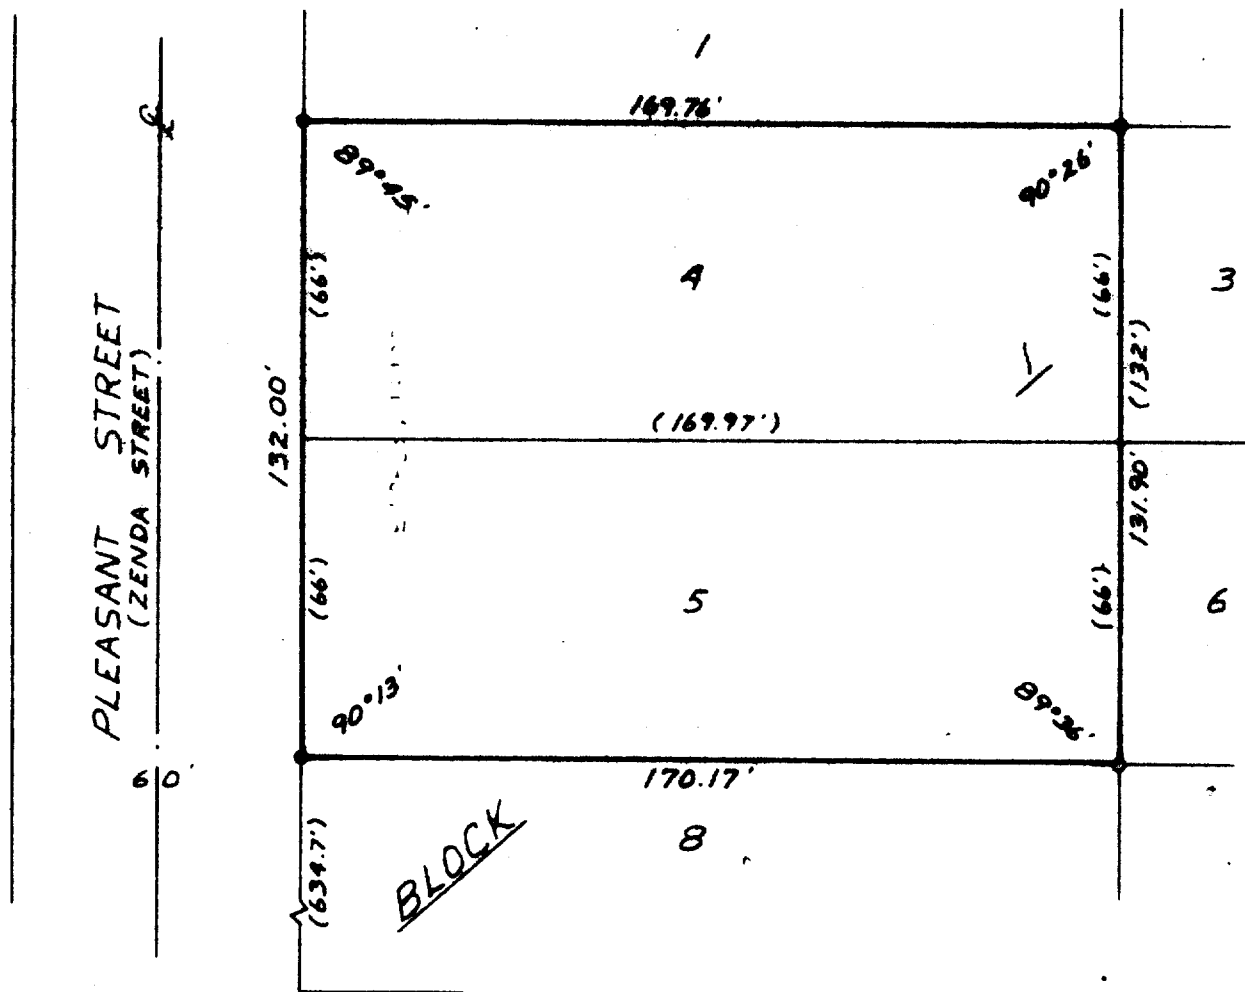

LOTS 4 AND 5, BLOCK 1 OF KUEBKER ADDITION,
TOWN 1 NORTH, RANGE 17 EAST, WALWORTH
COUNTY, WISCONSIN.

LEGEND
 x - IRON PIPE FOUND
 o - IRON PIPE PLACED
 () - RECORDED AS

THIS SURVEY IS MADE FOR THE USE OF THE PRESENT OWNERS OF THE PROPERTY, AND ALSO THOSE WHO PURCHASE, MORTGAGE, OR GUARANTEE THE TITLE THERETO WITHIN ONE (1) YEAR FROM DATE HEREOF.

Harold H. Kolb
HAROLD H. KOLB
WISCONSIN REGISTERED LAND SURVEYOR, S-187
DATE APRIL 18, 1983

117-658-K