
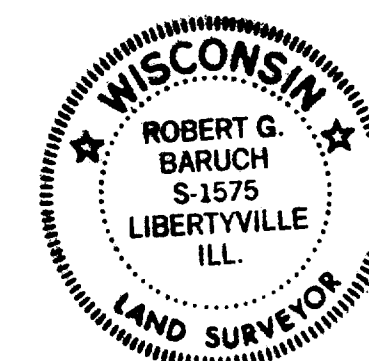
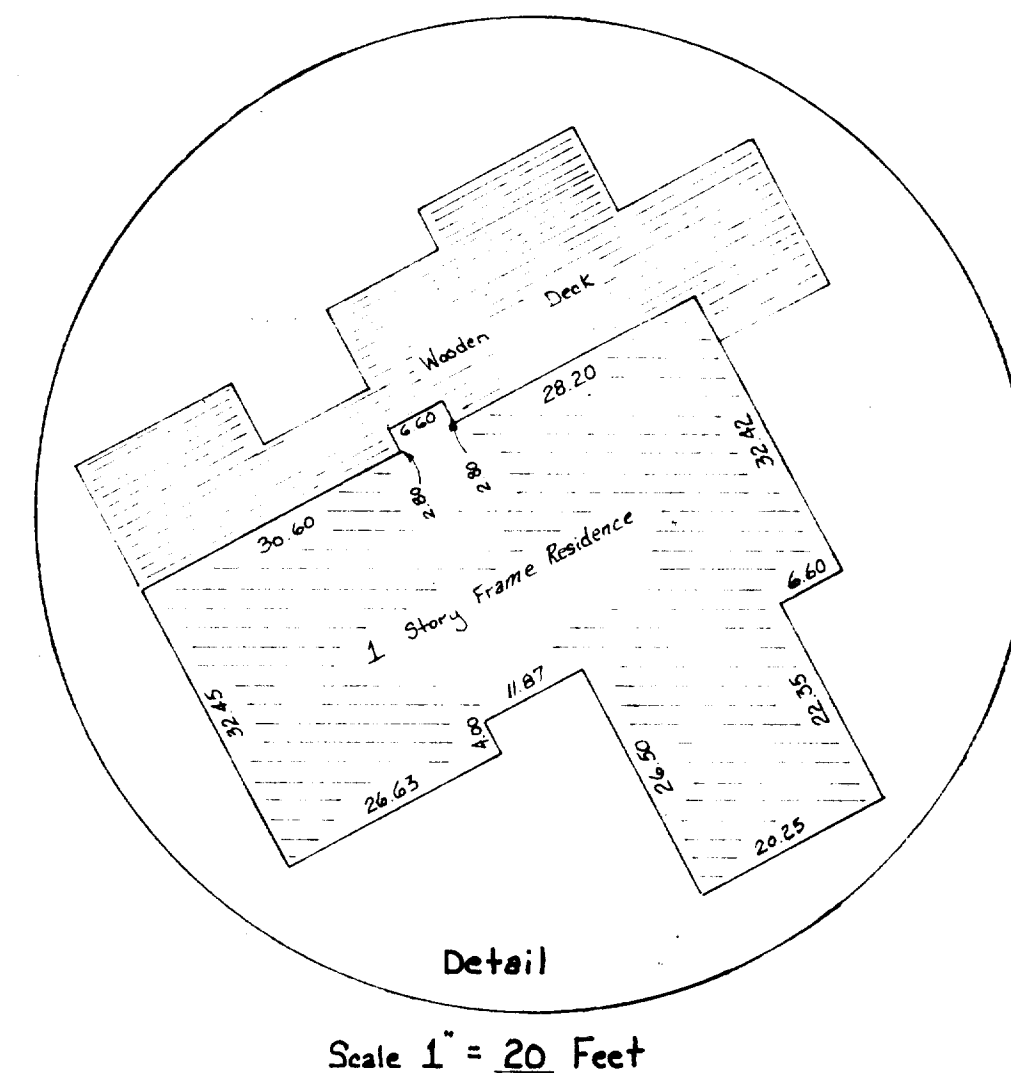


# PLAT OF SURVEY

THE NORTHERN COUNTIES GROUP, INC.

SURVEYORS  
339 North Milwaukee Avenue  
LIBERTYVILLE, ILLINOIS 60048  
(312) 367-4560

Lot 5, in Block 2, Trinke Estates, Section 10, Township 1 North, Range  
17 East, Walworth County, Wisconsin.

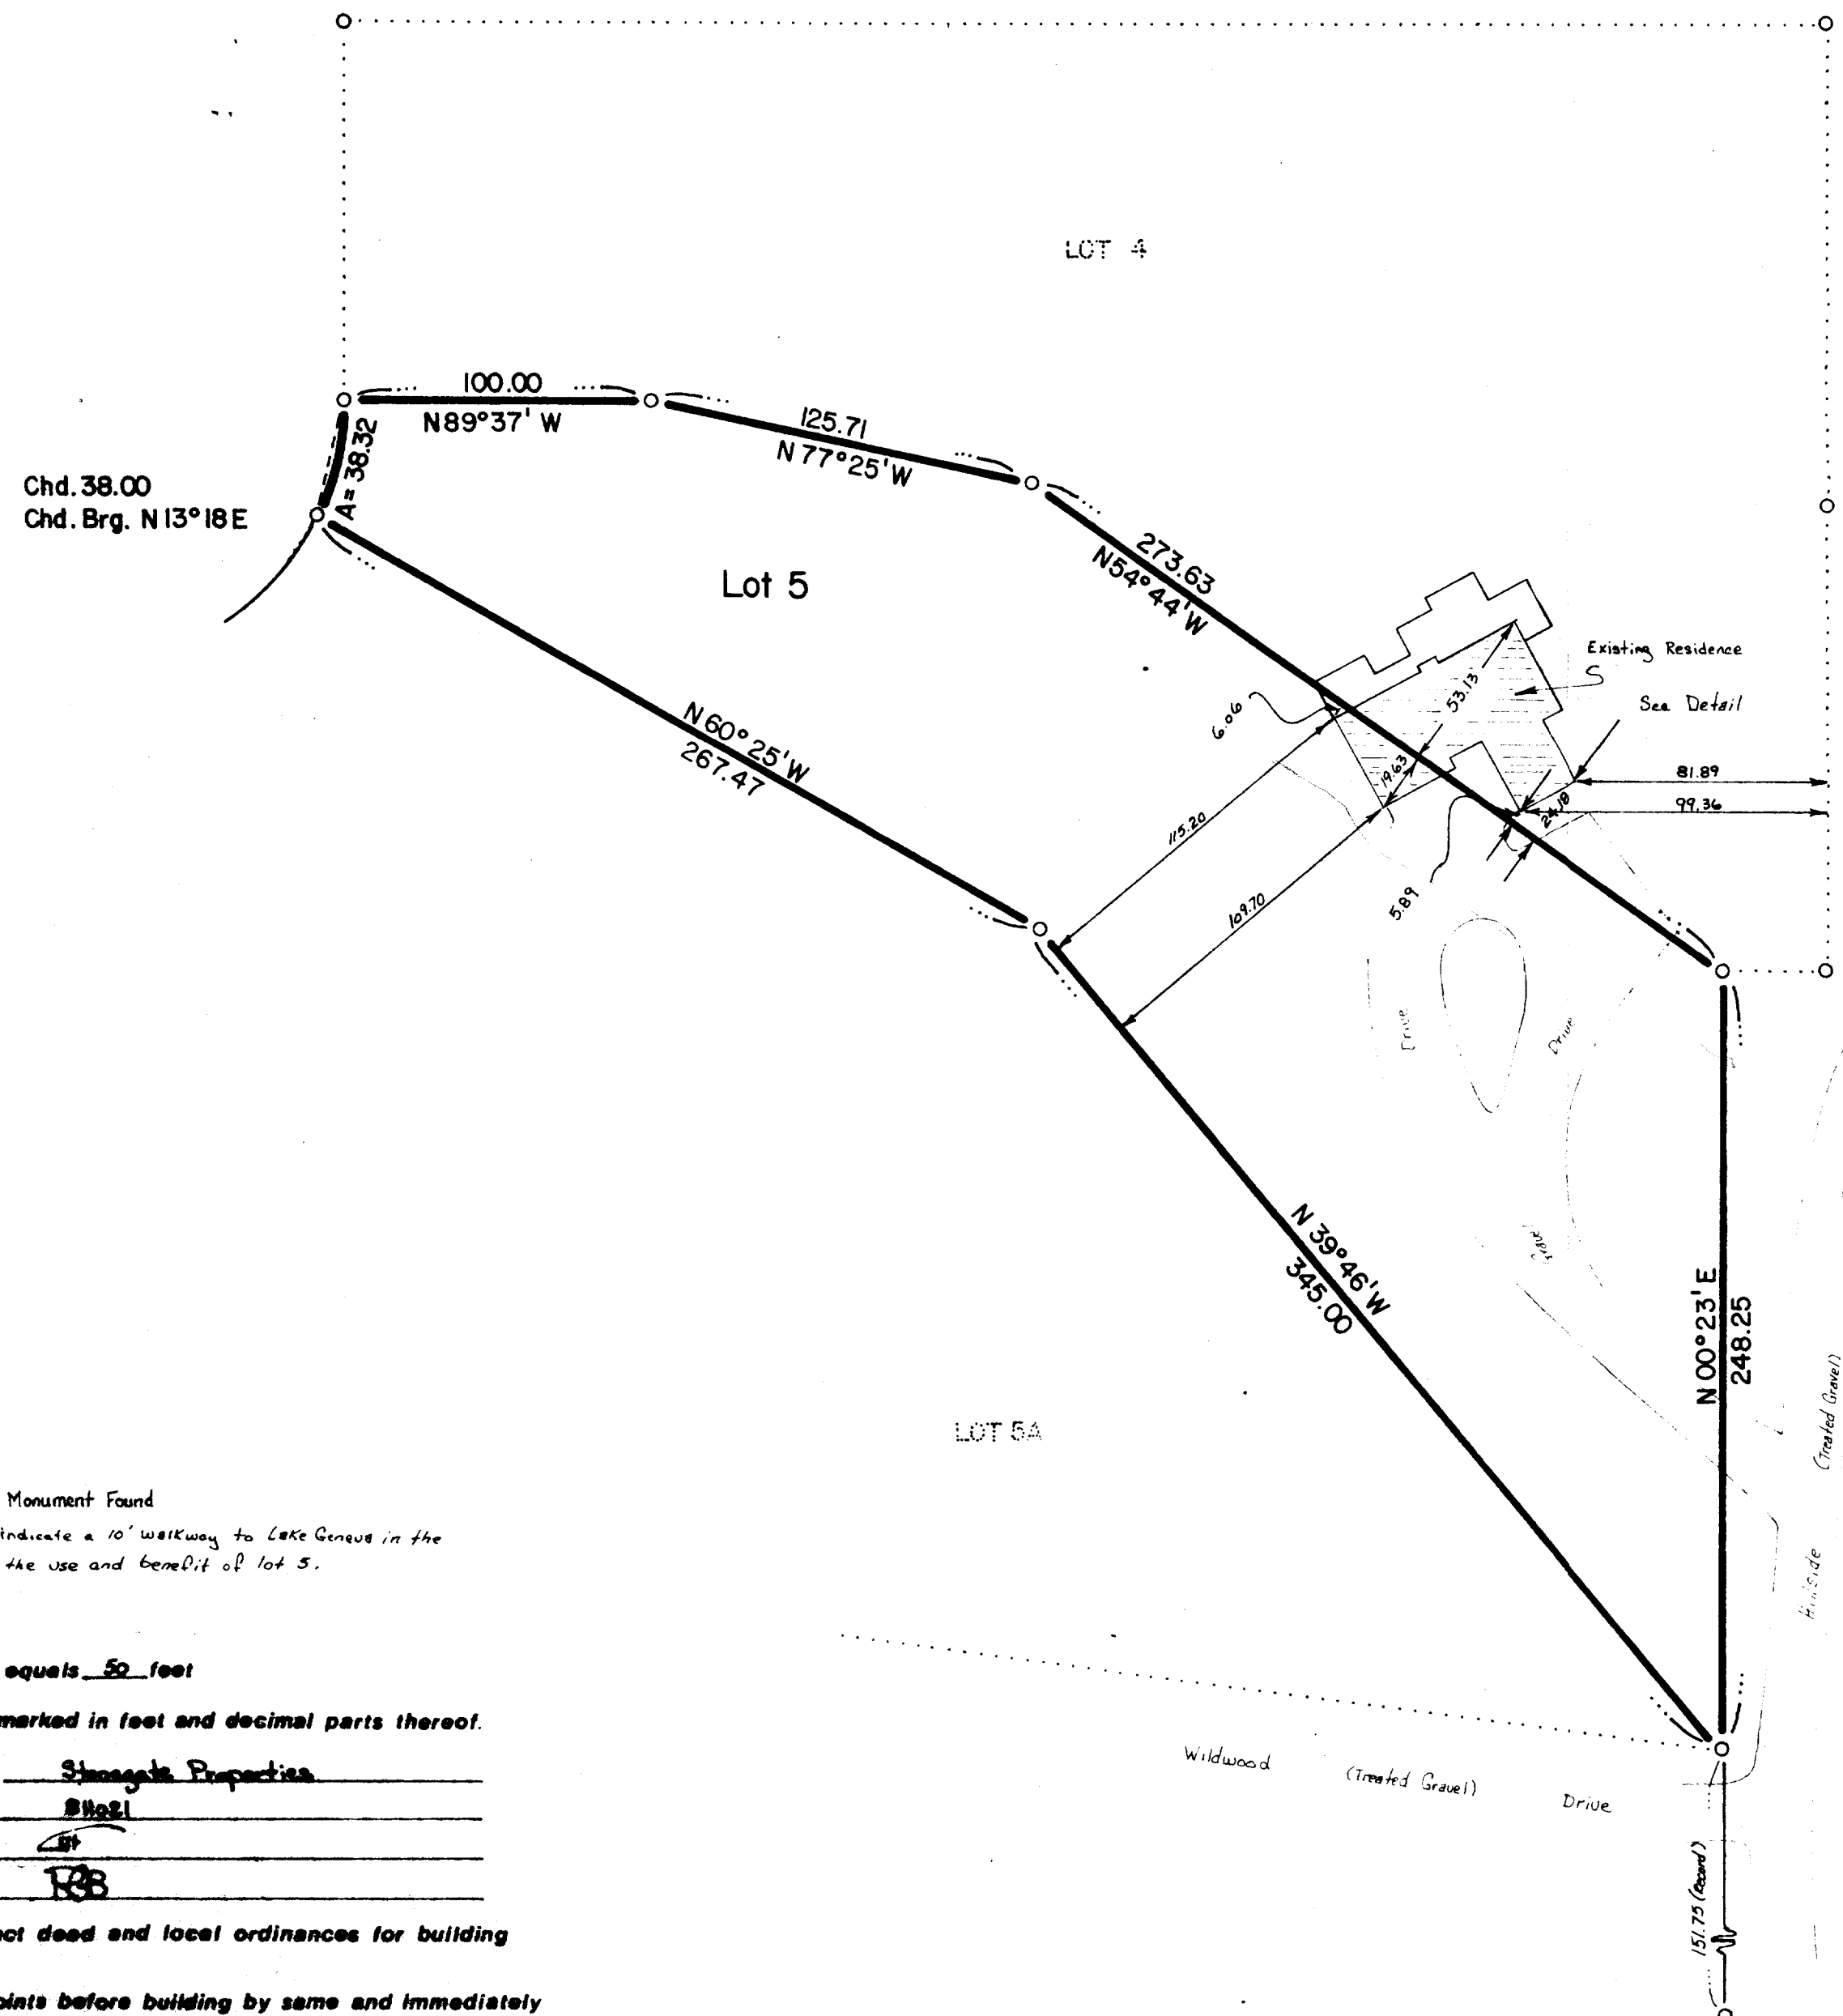

To: \_\_\_\_\_  
We, THE NORTHERN COUNTIES GROUP, INC., do hereby certify  
that we have surveyed the above described property and that the  
plat hereon drawn is a correct representation of said survey.

LIBERTYVILLE, ILLINOIS  
Dated this 26th day of February A.D. 19 81.  
Robert G. Baruch  
Wisconsin Registered Land Surveyor No. S-1575