


KOLB LAND CONSULTING, INC.
LAND SURVEYING • SUBDIVIDING • LAND PLANNING

LAKE GENEVA, WISCONSIN 53147

WHITEWATER, WISCONSIN 53190

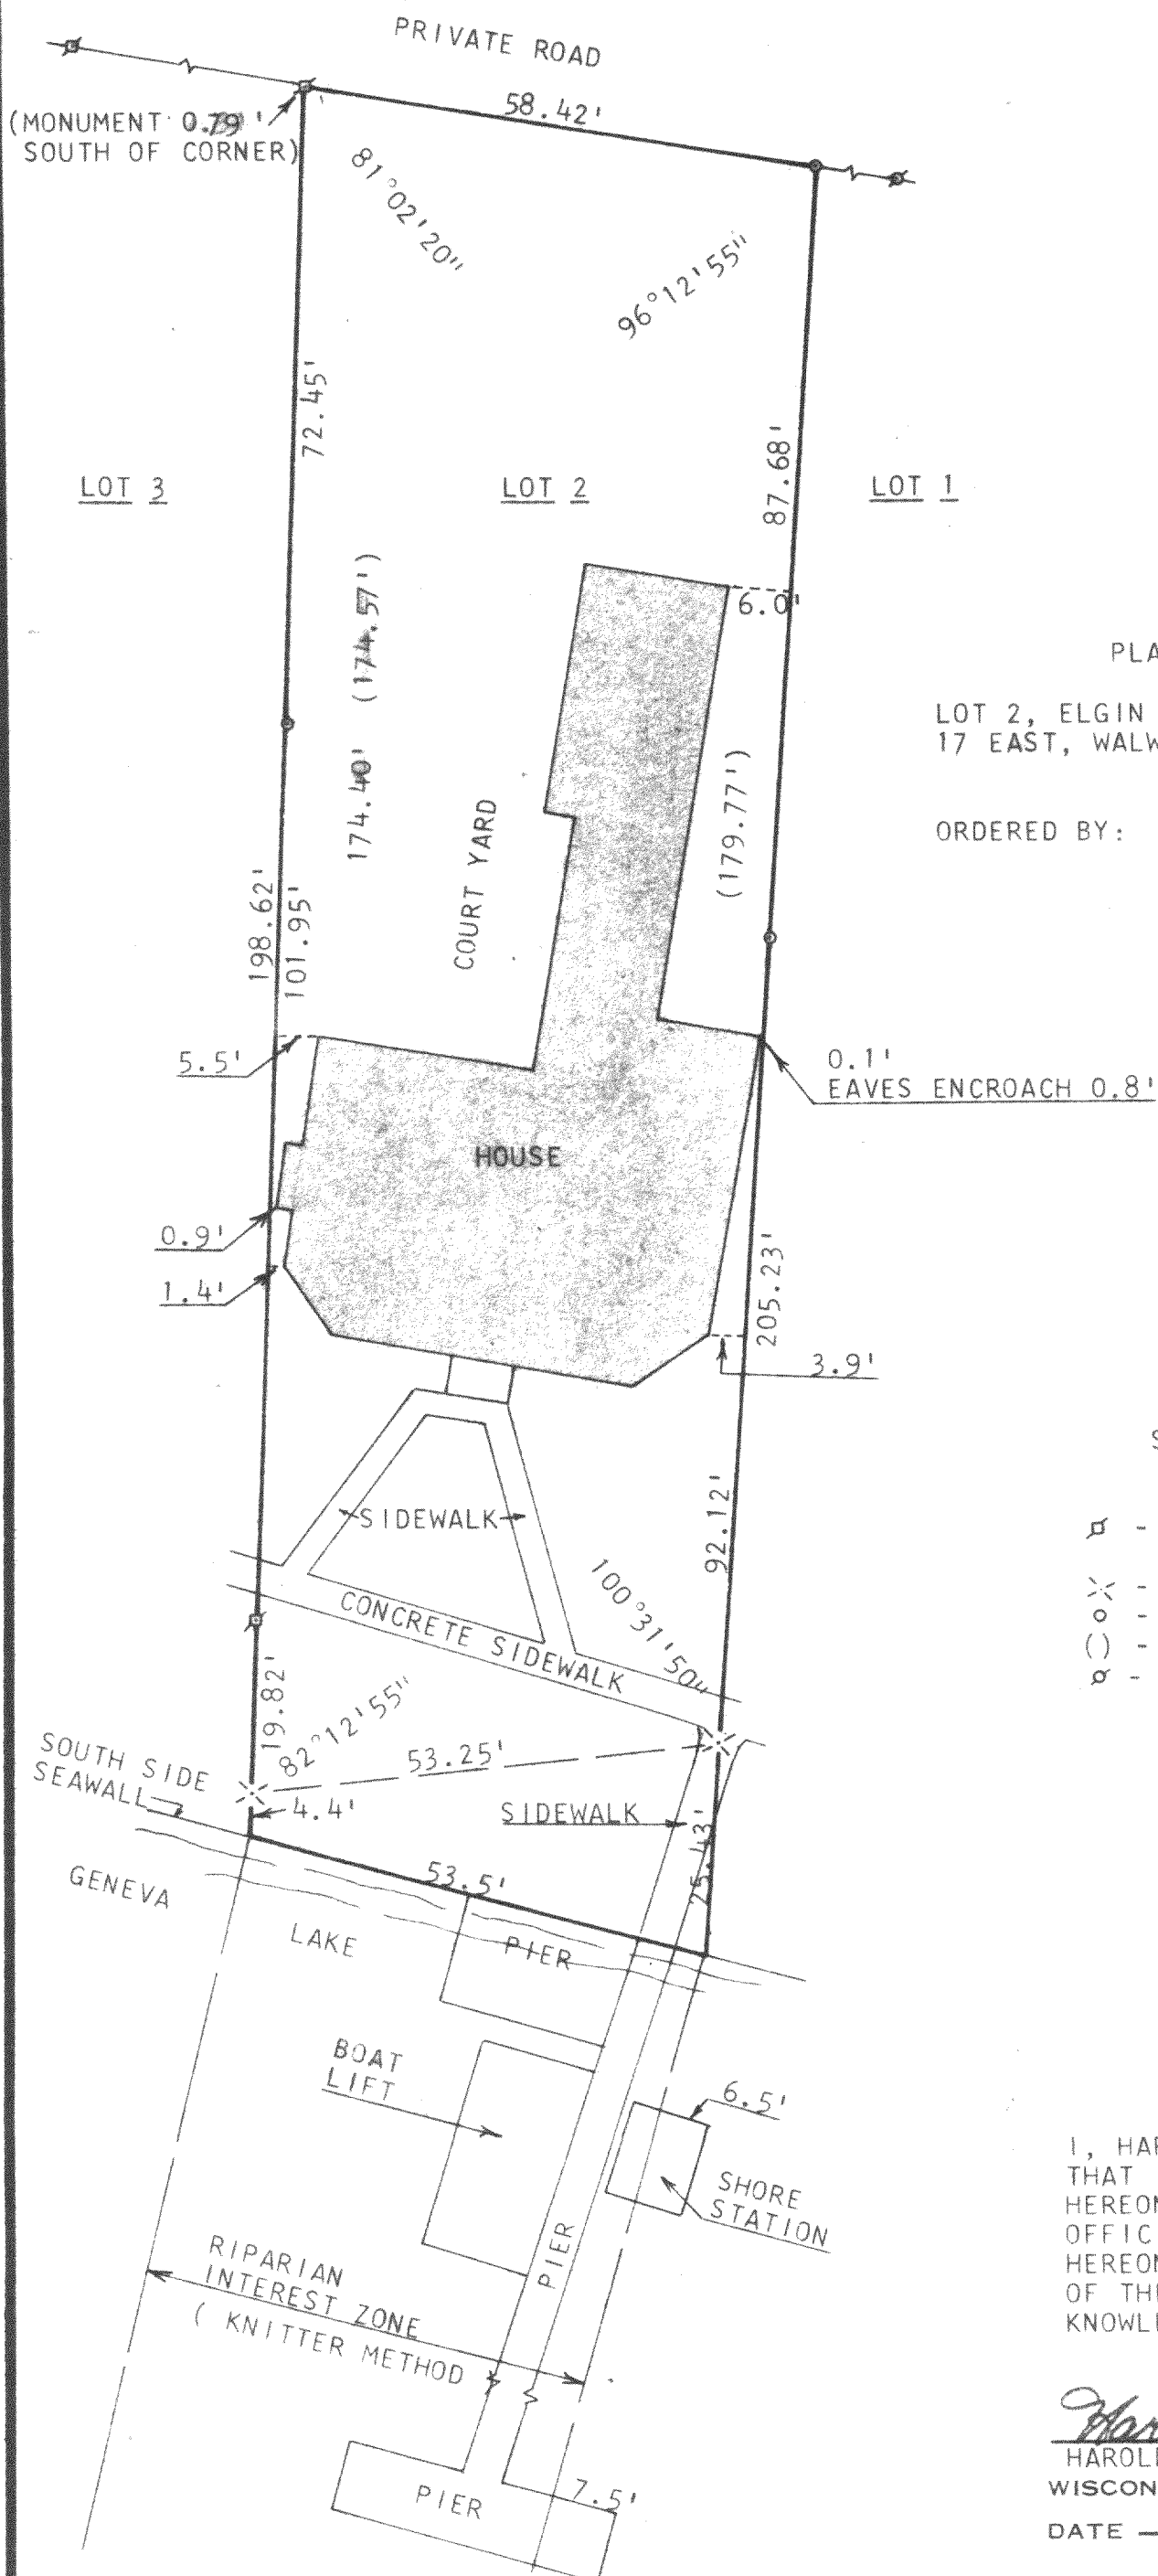

PLAT OF SURVEY OF

LOT 2, ELGIN CLUB, TOWN 1 NORTH, RANGE 17 EAST, WALWORTH COUNTY, WISCONSIN.


ORDERED BY: JOHN BARROWS
108 N. LAKE SHORE DR.
LAKE GENEVA, WI 53147



SCALE - 1"=20'

LEGEND

- ✱ - STONE MONUMENT WITH CUT CROSS FOUND
- ✕ - CUT CROSS FOUND
- - IRON PIPE SET
- () - RECORDED AS
- ✱ - IRON PIPE FOUND

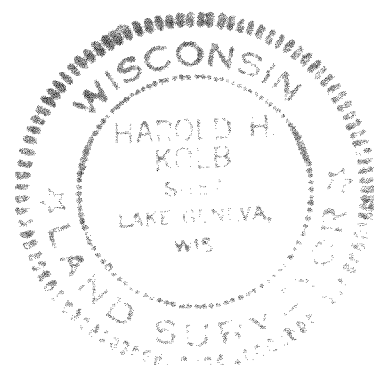

I, HAROLD H. KOLB, DO HEREBY CERTIFY THAT I HAVE SURVEYED THE PROPERTY HEREON DESCRIBED ACCORDING TO THE OFFICIAL RECORDS, AND THAT THE PLAT HEREON IS A CORRECT REPRESENTATION OF THE LOT LINES TO THE BEST OF MY KNOWLEDGE AND BELIEF.

Harold H. Kolb

HAROLD H. KOLB
WISCONSIN REGISTERED LAND SURVEYOR, S-187
DATE AUGUST 9, 1983

117-665-K