
## KOLB LAND CONSULTING, INC.

LAND SURVEYING . SUBDIVIDING . LAND PLANNING

LAKE GENEVA, WISCONSIN 53147

WHITEWATER, WISCONSIN 53190

STATE TRUNK HIGHWAY "50"

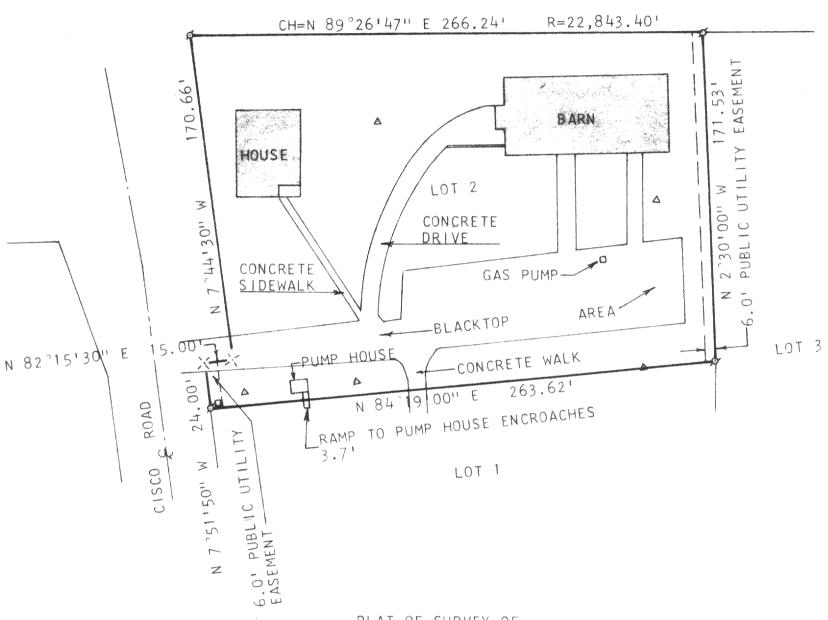

PLAT OF SURVEY OF

LOT 2 OF ARA GLEN ESTATES, TOWN 1 NORTH, RANGE 17 EAST, WALWORTH COUNTY, WISCONSIN.

ORDERED BY: BRADEN & OLSEN

716 WISCONSIN ST.

LAKE GENEVA, WI 53147

NOTE: BEARINGS ARE AS SHOWN ON THE SUBDIVISION

PLAT OF ARA GLEN ESTATES.



SCALE

1''=50'

LEGEND

Ø - IRON PIPE FOUND

> - RAILROAD SPIKE FOUND

- TELEPHONE PED.

A - MANHOLE



I, HAROLD H. KOLB, DO HEREBY CERTIFY THAT I HAVE SURVEYED THE PROEPRTY HEREON DESCRIBED ACCORDING TO THE OFFICIAL RECORDS, AND THAT THE PLAT HEREON IS A CORRECT REPRESENTATION OF THE LOT LINES AND THE PRINCIPAL LINES OF THE IMPROVEMENTS THEREON TO THE BEST OF MY KNOWLEDGE AND BELIEF.

Harold W. Roll

WISCONSIN REGISTERED LAND SURVEYOR, S-187
AUGUST 11, 1983