
KOLB LAND CONSULTING, INC.

LAND SURVEYING . SUBDIVIDING . LAND PLANNING

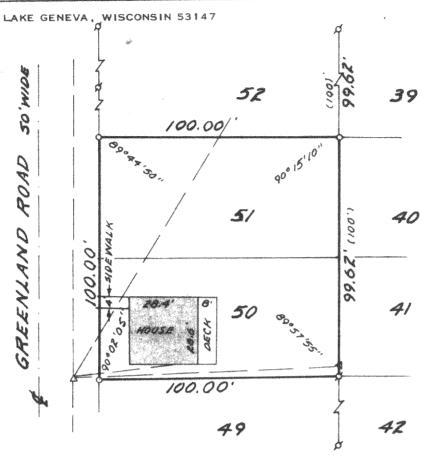

SCALE: 1"=40'

LEGEND Ø IRON PIPE FOUND • 1"X24" IRON PIPE SET A UTILITY POLE

-- OVERHEAD UTILITY LINES

PLAT OF SURVEY OF
LOTS 50 & 51, LAKE GENEVA HIGHLANDS, A
SUBDIVISION LOCATED IN THE SOUTHEAST 1/4
OF SECTION 8, T 1 N, R 17 E, TOWN OF LINN, WALWORTH COUNTY, WISCONSIN.

ORDERED BY: THE RAULAND AGENCY 118 KENOSHA STREET WALWORTH, WI. 53184 WILLIAM HOSKINS, 3582 TREATY LANE OWNER

FOR:

HOFFMAN ESTATES, IL. 60195

I HEREBY CERTIFY THAT I HAVE SURVEYED THE ABOVE DESCRIBED PROPERTY AND THAT THE ABOVE MAP IS A TRUE REPRESENTATION THEREOF AND SHOWS THE SIZE AND LOCATION OF THE PROPERTY, ITS EXTERIOR BOUNDARIES, THE LOCATION OF ALL VISIBLE STRUCTURES AND DIMENSIONS OF ALL PRINCIPAL BUILDINGS THEREON, BOUNDARY FENCES, APPARENT EASEMENTS, ROADWAYS AND VISIBLE ENCROACHMENTS, IF ANY, TO THE BEST OF MY KNOWLEDGE AND BELIEF

THIS SURVEY IS MADE FOR THE USE OF THE PRESENT OWNERS OF THE PROPERTY, AND ALSO THOSE WHO PURCHASE, MORTGAGE, OR GUARANTEE THE TITLE THERETO WITHIN ONE (1) YEAR FROM THE DATE HEREOF.

HAROLD H. KOLB WISCONSIN REGISTERED LAND SURVEYOR, S-187

OCT. 29, 1984