

ROBERT BRAUER LAND SURVEYING

residential

agricultural


commercial

FONTANA, WI.

(414) 275-6359

PLAT OF SURVEY

Lots 41 and 42 in Paradise Vista Subdivision, Town of Linn,
Walworth County, Wisconsin.

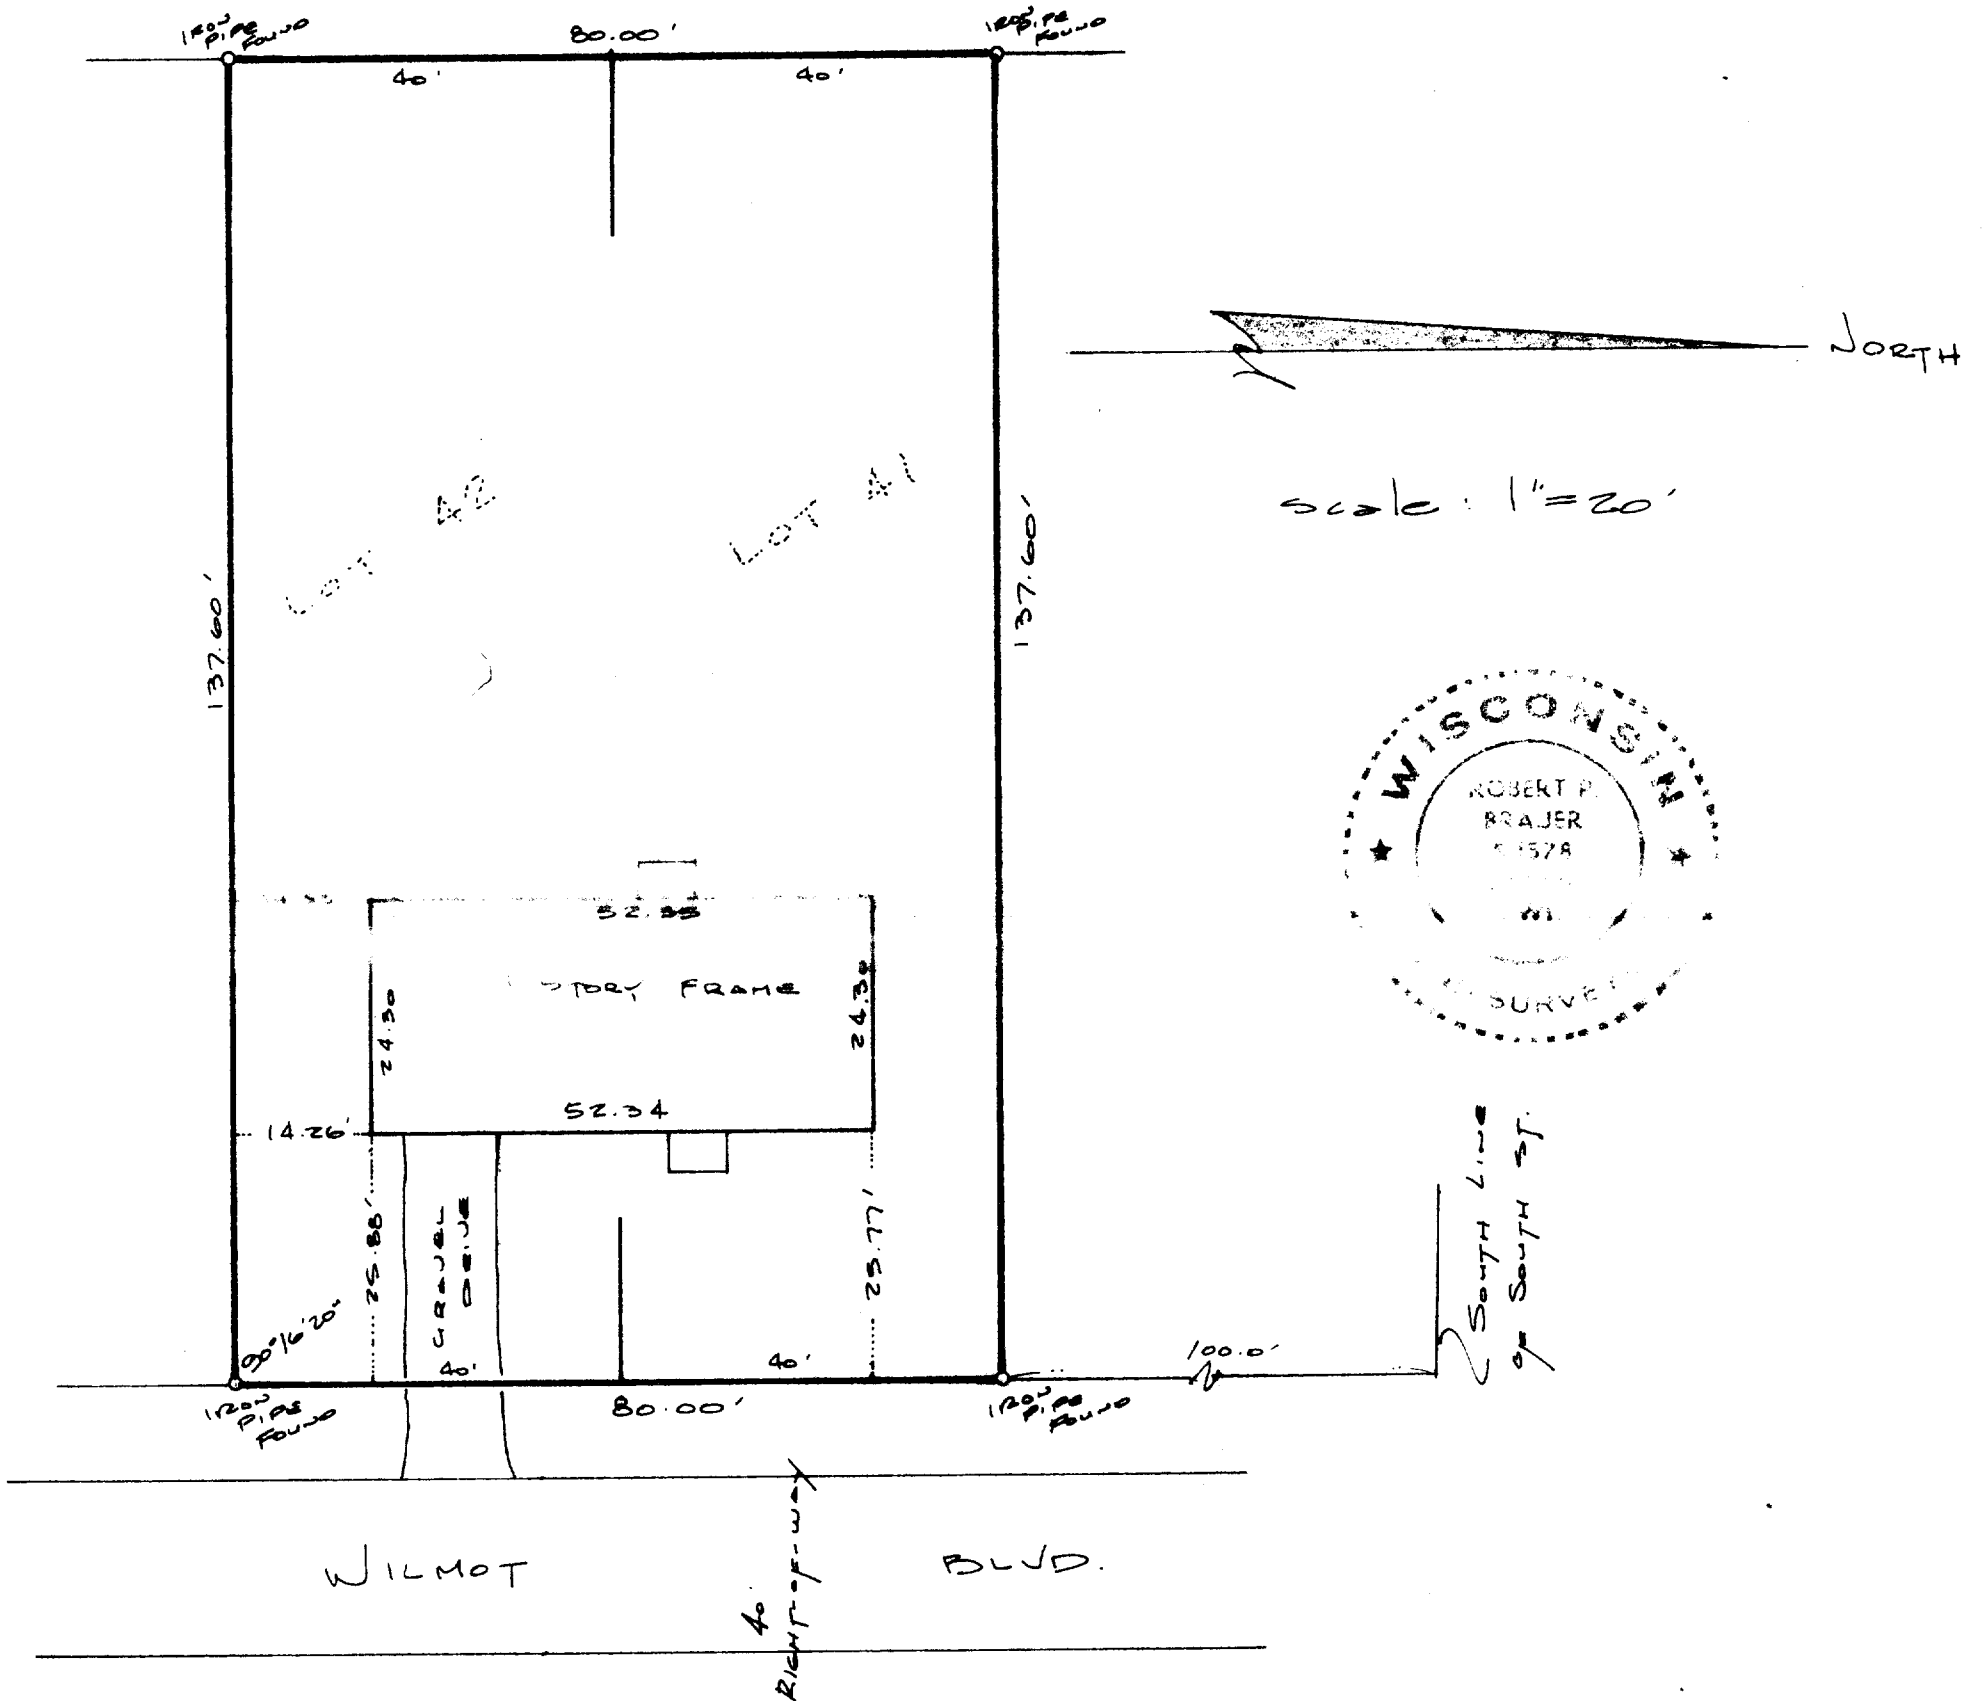

I HEREBY CERTIFY THAT I HAVE SURVEYED THE ABOVE DESCRIBED PROPERTY AND THE ABOVE MAP IS A TRUE REPRESENTATION THEREOF AND SHOWS THE SIZE AND LOCATION OF THE PROPERTY, ITS EXTERIOR BOUNDARIES, THE LOCATION OF ALL VISIBLE STRUCTURES AND DIMENSIONS OF ALL PRINCIPLE BUILDINGS THEREON, BOUNDARY FENCES, APPARENT EASEMENTS, ROADWAYS AND VISIBLE ENCROACHMENTS, IF ANY.

THIS SURVEY IS MADE FOR THE PRESENT OWNERS OF THE PROPERTY, AND ALSO THOSE WHO PURCHASE MORTGAGE, OR GUARANTEE THE TITLE THERETO WITHIN ONE YEAR FROM DATE THEREOF.

DATED AT McHenry, IL THIS 14th DAY OF June 1983

Robert P. Brauer

ROBERT P. BRAUER Registered Land Surveyor 1578

No. 83265

117-690