


WALWORTH COUNTY  
SURVEYING & MAPPING  
LAKE GENEVA, WISCONSIN

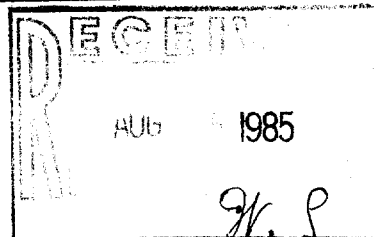


PLAT OF SURVEY OF

LOT 10, BLOCK 1, TRINKE ESTATES, TOWN 1  
NORTH, RANGE 17 EAST, WALWORTH COUNTY,  
WISCONSIN.

ORDERED BY: JOHN LAW REALTORS  
803 MAIN STREET  
LAKE GENEVA, WISCONSIN 53147

LEGEND  
⊘ - IRON PIPE FOUND  
○ - IRON PIPE SET  
( ) - RECORDED AS

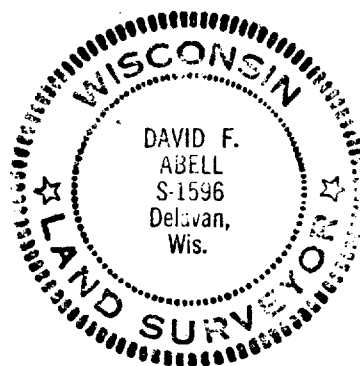

I HEREBY CERTIFY THAT I HAVE SURVEYED THE  
ABOVE DESCRIBED PROPERTY AND THAT THE ABOVE  
MAP IS A TRUE REPRESENTATION THEREOF AND  
SHOWS THE SIZE AND LOCATION OF THE PROPERTY,  
ITS EXTERIOR BOUNDARIES, THE LOCATION OF ALL  
PRINCIPAL BUILDINGS THEREON, BOUNDARY FENCES,  
APPARENT EASEMENTS, ROADWAYS AND VISIBLE  
ENCROACHMENTS, IF ANY, TO THE BEST OF MY  
KNOWLEDGE AND BELIEF.

THIS SURVEY IS MADE FOR THE USE OF THE  
PRESENT OWNERS OF THE PROPERTY, AND ALSO  
THOSE WHO PURCHASE, MORTGAGE, OR GUARANTEE  
THE TITLE THERETO WITHIN ONE (1) YEAR FROM  
DATE HEREOF.

*David F. Abell*

DAVID F. ABELL  
WISCONSIN REGISTERED LAND SURVEYOR, S-1596

*May 10, 1985*  
DATE

JOB NUMBER 0255

SCALE - 1"=50'



**BLOCK**

**HILLSIDE ROAD**

HOLLIS GUNYON  
HARBOR

BUILDING LINE

WOOD DECK

HOUSE

WELL

CONC. DRIVE

SEPTIC

(S84°34'W 100.52') 100.36'

(N0°23'E)

FENCE ON LINE

(N0°23'E 424.51')

226.04'

418.89'

(N0°23'E 424.51')

164.35'

98°48'25"

100.36'

61.2'

63.4'

30.9'

121.07'

84°18'30"

20.3'

18.4'

27.0'

34.6'

36.1'

18.0'

8.9'

5.1'

7.8'

22.1'

12.0'

6.0'

34.6'

36.1'

18.0'

8.9'

5.1'

7.8'

22.1'

12.0'

6.0'

34.6'

36.1'

18.0'

8.9'

5.1'

7.8'

22.1'

12.0'

6.0'

34.6'

36.1'

18.0'

8.9'

5.1'

7.8'

22.1'

12.0'

6.0'

34.6'

36.1'

18.0'

8.9'

5.1'

7.8'

22.1'

12.0'

6.0'

34.6'

36.1'

18.0'

8.9'

5.1'

7.8'

22.1'

12.0'

6.0'

34.6'

36.1'

18.0'

8.9'

5.1'

7.8'