


## Farris, Hansen & Associates, Inc.

Engineers, Architects and Surveyors
P.O. BOX 487
7 RIDGEWAY COURT
ELKHORN, WISCONSIN 53121

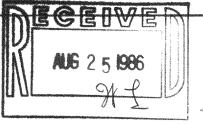

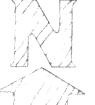

PLAT OF SURVEY OF LOTS 4,5,6, &38 EXCEPTING SOUTH 5 FT. LOT 38
OF PARADISE VISTA LOCATED IN SE 1/4 SECTION 1, T.IN., R. 17E.
WALWORTH COUNTY, YVISCONSIN

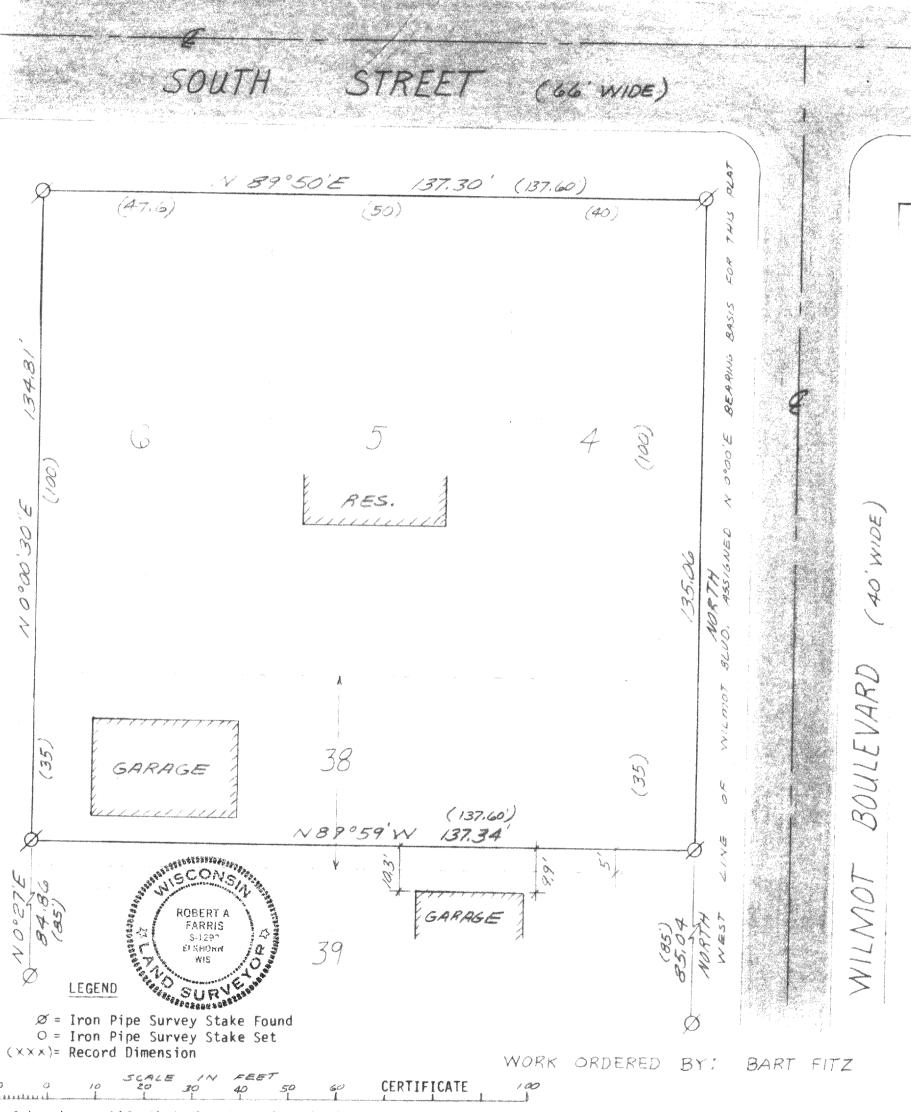

I hereby certify that the above described property has been surveyed under my direction and that the above map is a true representation thereof and shows the size and location of the property, its exterior boundaries, the location of all visible structures and dimensions of all principal buildings thereon, boundary fences, apparent easements, roadways and visible encroachments, if any.

This survey is made for the use of the present owners of the property, and also for those who purchase, mortgage, or guarantee the title thereto within one (1) year from the date hereof.

Robert A. Farris, R.L.S.

Dated this 18thday of JULY , 1986

PROJECT NO. 2620