


DUNHAM SURVEYING, S.C.
SURVEYING & SUBDIVIDING
DELAVER, WISCONSIN 53115

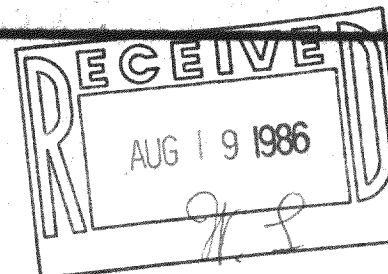

Steps from the top of the hill to the lake are located on Lot 8, the West 20' of Lot 9 and on the remainder of Lot 9, all adjacent to each other. In a few places the ends of steps or posts encroach by all 3 property owners on to the adjoining property with a maximum of 0.2' and more often less than .01'

N

Scale - 1" = 40'
 • = 1/2" Iron Pipe Found
 • = 3/4" Iron Pipe Found
 • = 1" Iron Pipe Found
 • = 1 1/4" Iron Pipe Found
 • = 1 1/2" Iron Pipe Found
 (0.00) = recorded distance
 Survey ordered by:
 James G. Militello
 40 Brink Street
 Crystal Lake, IL 60014

STATE OF WISCONSIN) SS
COUNTY OF WALWORTH)

I, George T. Dunham, Surveyor, certify that I have surveyed the property described as follows:

Parcel 1: Beginning at the southwest corner of Lot 9, Block 1 of Wooddale Addition located in Section 9, T1N, R17E, Walworth County, Wisconsin, thence northwesterly along the Southwesterly line of said Lot 9, 158.55 feet more or less to the low water mark of Geneva Lake; thence northeasterly along the shore of Geneva Lake 20 feet; thence Southeasterly on a line that is parallel with the westerly line of said Lot 9 and 20 feet distant therefrom 162.57 feet more or less to the southerly line of said Lot 9; thence Southwesterly along the Southerly line of said Lot 9, 20 feet to the place of beginning.


Parcel 2: Lot 17, Block 3 of Wooddale Addition located in Section 9, T1N, R17E, Walworth County, Wisconsin together with a right of way 20 feet in width North and South which runs from the point where the north line of Lot 22 of Block 3 of Wooddale Addition in T1N, R17E, of Walworth County, Wisconsin, intersects Lake View Road as platted in said subdivision in a Northeasterly direction along the Northerly line of said Lot 22 a distance of 73.29 feet to a point where said easement as now established intersects the easement described in the Land Contract running from Frank Marchese and wife to Frank E. Dyslin and wife, dated January 3, 1956 and recorded March 10, 1956 in Vol. 338 of Mortgages on page 567, but apparently never used.

thence running North 2°09'E to the premises purchased by Edith M. Holm by deed dated September 11, 1958 and recorded January 16, 1959 in Volume 535 of Deeds on page 203, Walworth County Records.

Parcel 3: All that portion of Lot 21, Block 3 of Wooddale Addition located in Section 9, T1N, R17E, of Walworth County, Wisconsin, which lies East of a line that is a continuation southerly of the boundary line between Lots 17 and 18 of said Block 3, excepting beginning at the southeast corner of said Lot 21; thence South 78°33'W along the south line of said Lot 21, 73.90 feet; thence N21°04'W along a line 27.13 feet, being the West line of Lot 17 of Block 3 extended in a southeasterly direction; thence N78°52'E 72.55 feet to a point on the east line of said Lot 21, 27.05 feet Northwesterly of the southeast corner of said Lot 21; thence South 23°46'E along said east line 27.05 feet to the place of beginning.

Parcel 4: That particular portion platted as "path" on Plat of Wooddale Addition located between Lot 17, Block 3 of Wooddale Addition and that portion of Lot 21 in said Block that lies East of the extension Southerly of the West line of Lot 17 in said Block to the South line of Lot 21 in said Block, all as shown on the Plat of Wooddale Addition located in Section 9, T1N, R17E, Walworth County, Wisconsin, and that the map shown hereon is a true representation thereof and shows the size and location of the property, its exterior boundaries, the location of all visible structures, and dimensions of all principal buildings thereon, boundary fences, apparent easements, roadways and visible encroachments, if any, and that I have surveyed the property hereon described according to the official records to the best of my knowledge and belief.
November 13, 1984

George T. Dunham
George T. Dunham, Surveyor

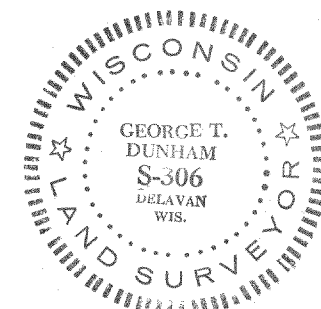

Easement 20 feet more or less in width described in the Land Contract running from Frank Marchese & wife to Frank E. Dyslin & wife, dated January 3, 1956 & recorded March 10, 1956 in Vol. 338 of Mortgages on Page 567, but apparently never used.