


RECEIVED
 SEP 26 1986

**WALWORTH COUNTY
 SURVEYING & MAPPING
 LAKE GENEVA, WISCONSIN**


HILLSIDE ROAD

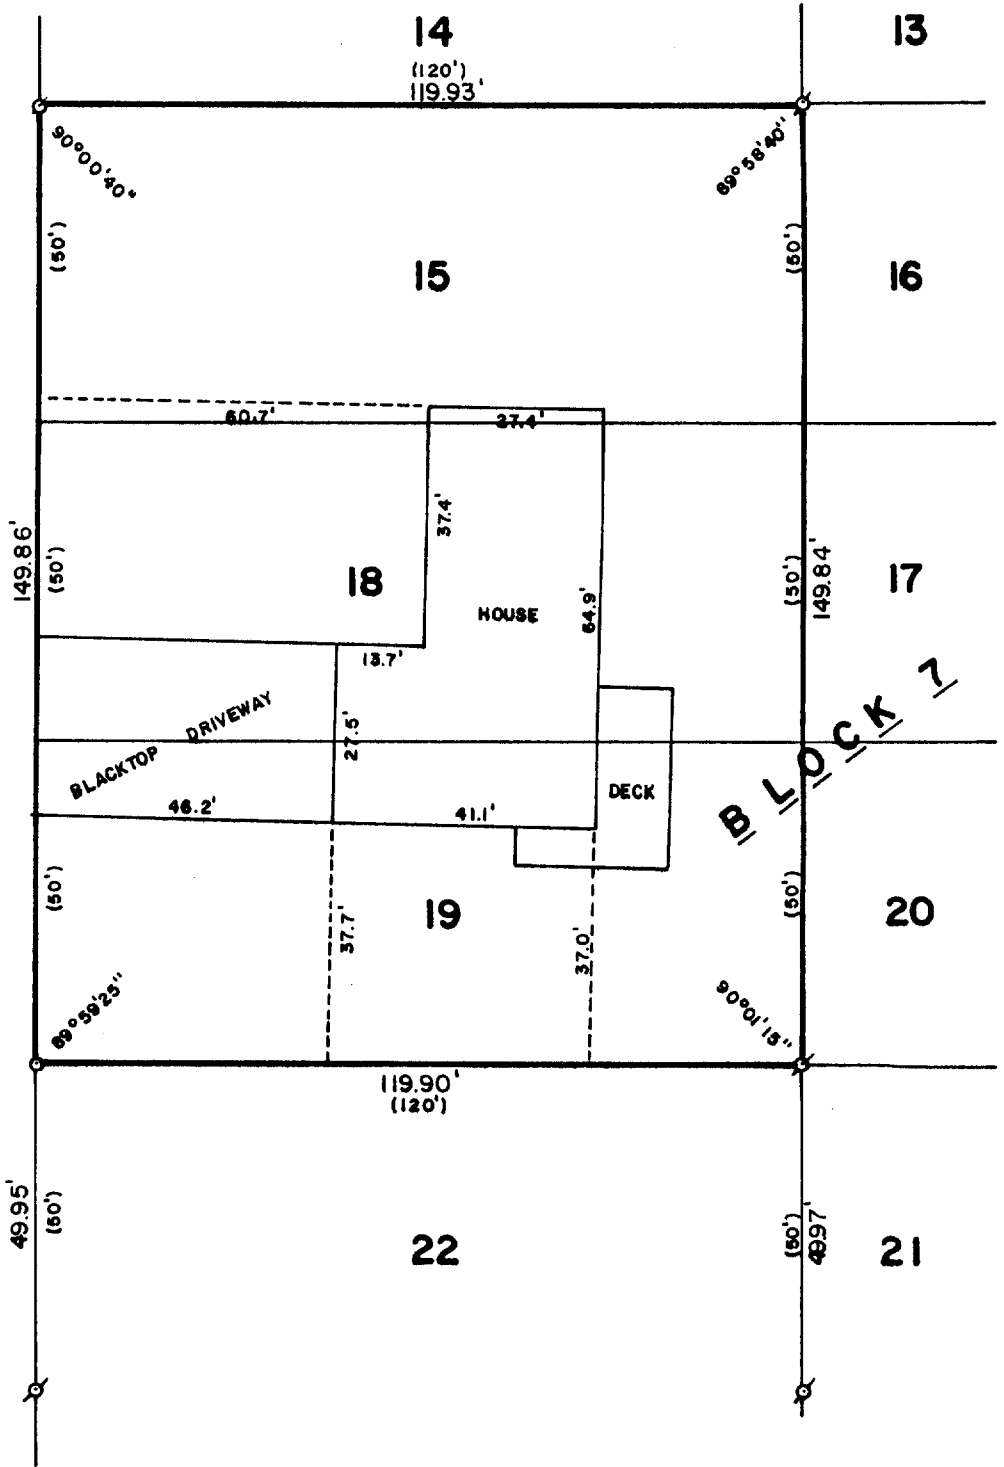

PLAT OF SURVEY OF

**LOTS 15, 18 AND 19, BLOCK 7 OF ROBINSON'S
 HILLSIDE SUBDIVISION, LOCATED IN SECTION
 14, T 1 N, R 17 E, WALWORTH COUNTY, WISCONSIN.**

**ORDERED BY: KENOSHA SAVINGS & LOAN
 410 BROAD STREET
 LAKE GENEVA, WISCONSIN 53147**

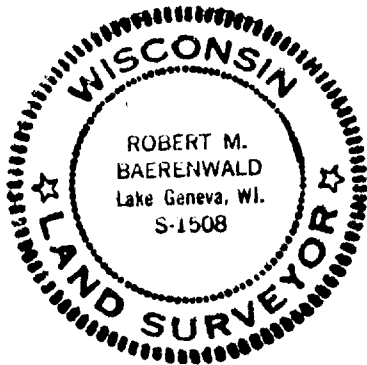

SCALE: 1"=30'

- ⊕ - IRON PIPE FOUND
- - IRON ROD PLACED
- () - RECORDED AS

I, ROBERT M. BAERENWALD, DO HEREBY CERTIFY THAT I HAVE SURVEYED THE PROPERTY HEREON DESCRIBED ACCORDING TO THE OFFICIAL RECORDS AND THAT THE PLAT HEREON IS A CORRECT REPRESENTATION OF THE PROPERTY LINES TO THE BEST OF MY KNOWLEDGE AND BELIEF.

Robert M. Baerenwald
 ROBERT M. BAERENWALD
 WISCONSIN REGISTERED LAND SURVEYOR, S-1508

DATE July 17, 1986 JOB NO. 0650