


WALWORTH COUNTY SURVEYING & MAPPING LAKE GENEVA, WISCONSIN

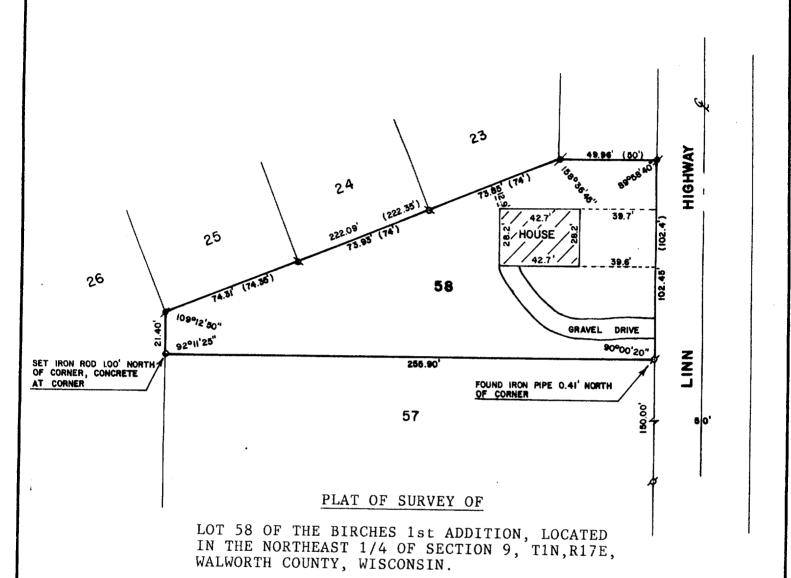

ORDERED BY:

COLDWELL BANKER GENEVA LAKES AREA REALTORS

838 MAIN STREET

LAKE GENEVA, WISCONSIN 53147



SCALE - 1"=50'

LEGEND

ø - IRON PIPE FOUND

CONCRETE MONUMENT FOUND

- IRON ROD SET

() - RECORDED AS

I, ROBERT M. BAERENWALD, DO HEREBY CERTIFY THAT I HAVE SURVEYED THE PROPERTY HEREON DESCRIBED ACCORDING TO THE OFFICIAL RECORDS AND THAT THE PLAT HEREON IS A CORRECT REPRESENTATION OF THE PROPERTY LINES TO THE BEST OF MY KNOWLEDGE AND BELIEF.

ROBERT M. BAFRENWALD

WISCONSIN REGISTERED LAND SURVEYOR, S-1508

DATE JOB NO. 0735

NOTE: THIS IS NOT A CERIFIED COPY UNLESS SEALED.

1BA1-41