

## WALWORTH COUNTY SURVEYING & MAPPING LAKE GENEVA, WISCONSIN

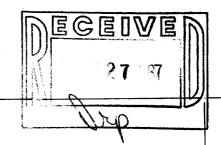

## **POPLAR** STREET

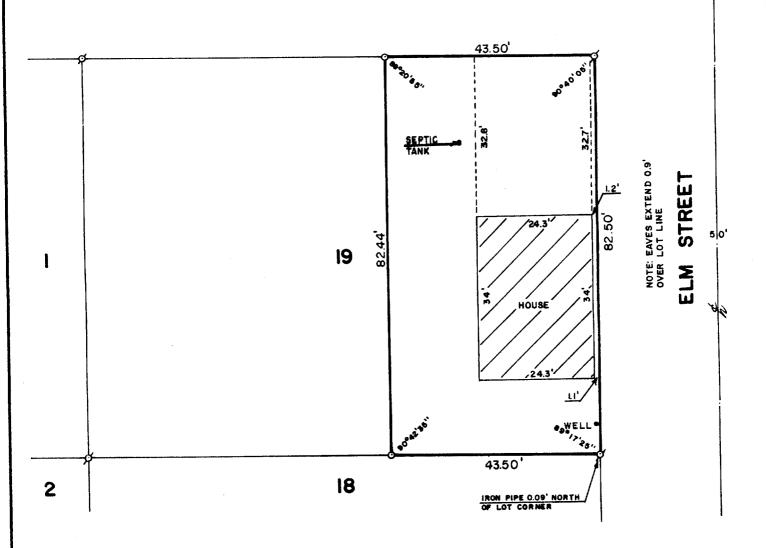

## PLAT OF SURVEY OF

THE EAST 43.5 FEET OF LOT 19 OF ROBINSON'S FIRST ADDITION, LOCATED IN T 1 N, R 17 E, WALWORTH COUNTY, WISCOMSIN.

> PIONEER SAVINGS ORDERED BY:

549 KENOSHA STREET

WALWORTH, WISCONSIN 53184



SCALE:

ø-IRON PIPE FOUND o - IRON ROD PLACED I, ROBERT M. BAERENWALD, DO HEREBY CERTIFY THAT I HAVE SURVEYED THE PROPERTY HEREON DESCRIBED ACCORDING TO THE OFFICIAL RECORDS AND THAT THE PLAT HEREON IS A CORRECT REPRESENTATION OF THE PROPERTY LINES TO THE BEST OF MY KNOWLEDGE AND BELIEF.

Suumal WISCONSIN REGISTERED LAND SURVEYOR, S-1508

1986 DATE JOB NO. 0897

THIS IS NOT A CERTIFIED COPY UNLESS SEALED. NOTE: