
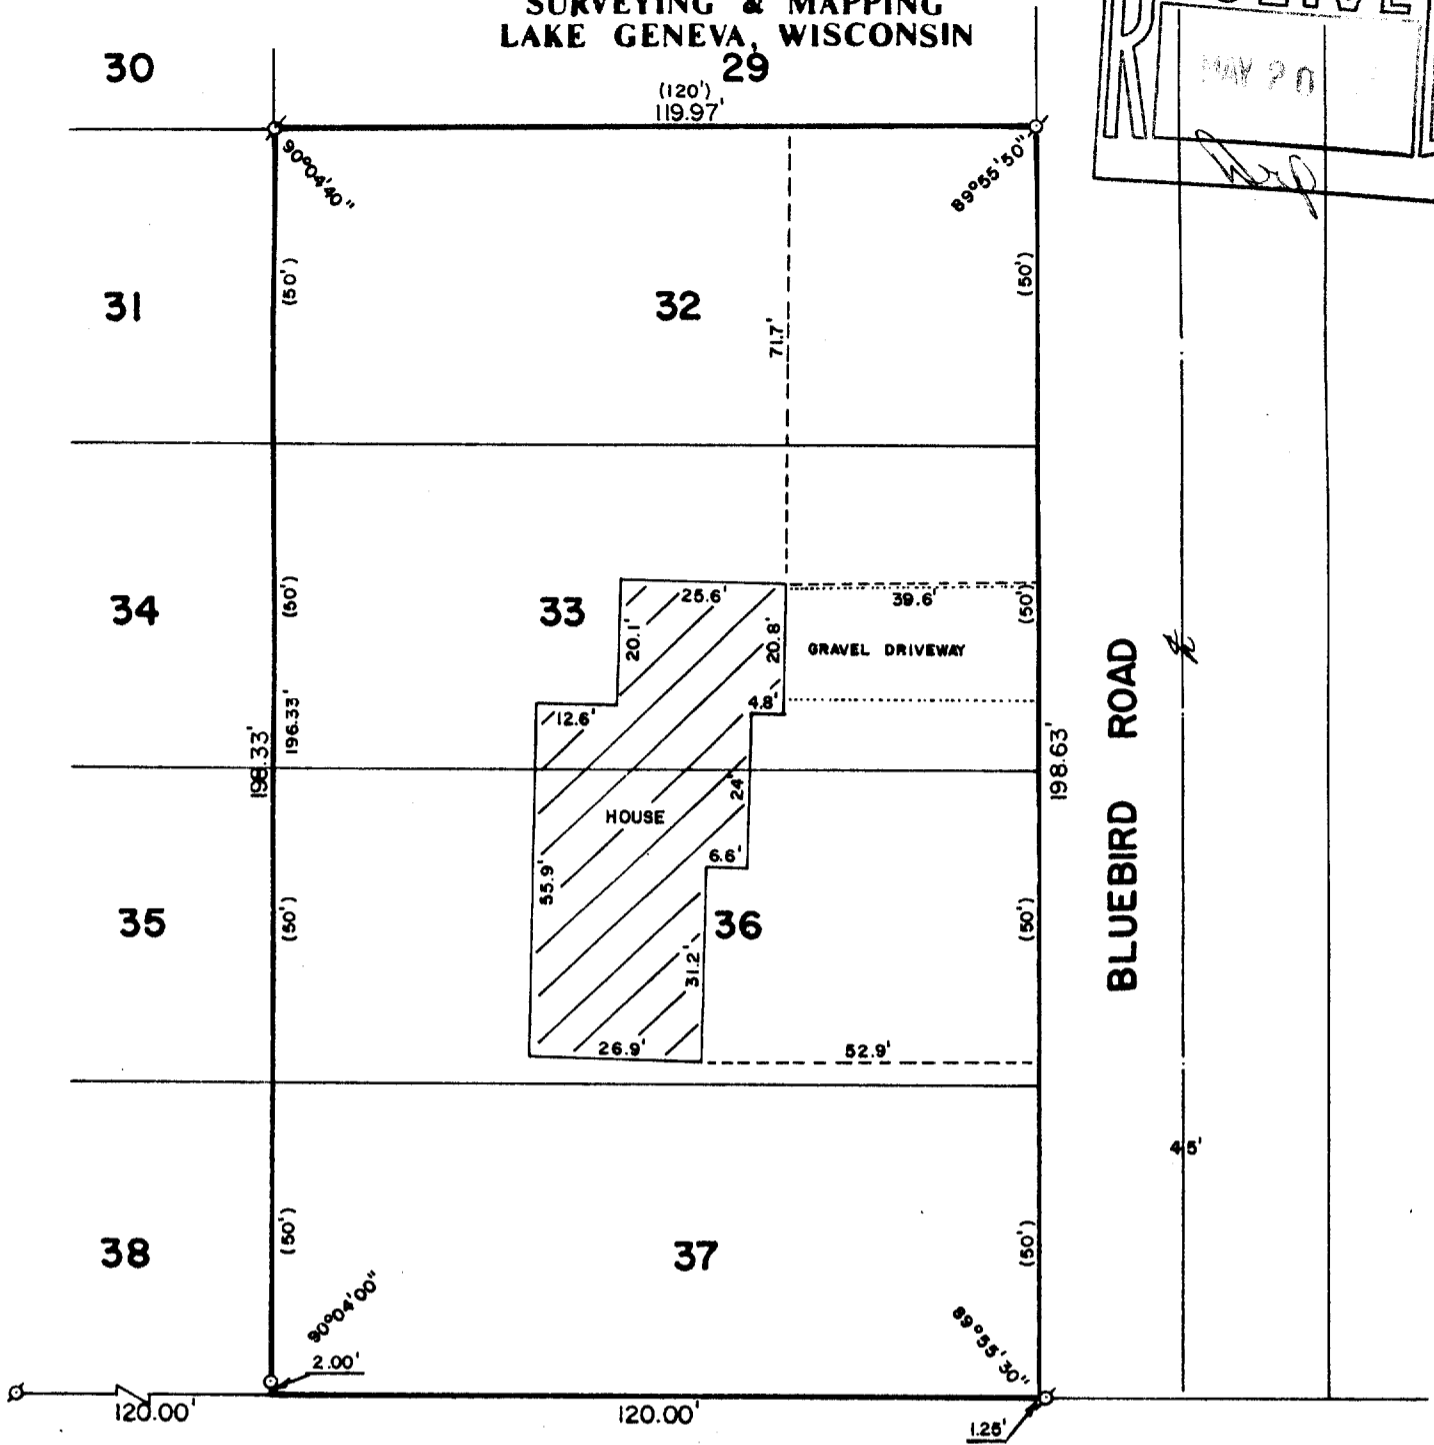


WALWORTH COUNTY  
SURVEYING & MAPPING  
LAKE GENEVA, WISCONSIN

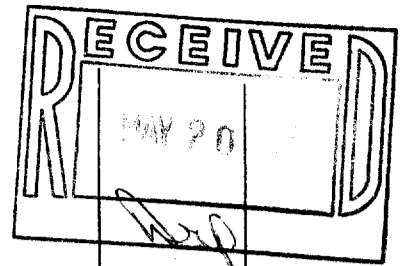

PLAT OF SURVEY OF

LOTS 32, 33, 36 AND 37 OF ROBINSON  
HILLSIDE, A SUBDIVISION LOCATED IN  
T 1 N, R 17 E, WALWORTH COUNTY,  
WISCONSIN.

ORDERED BY: CLEWLOW REALTY  
803 MAIN STREET  
LAKE GENEVA, WISCONSIN 53147



SCALE: 1"=30

- ⊙ - IRON PIPE FOUND
- - IRON ROD PLACED
- ( ) - RECORDED AS

I, ROBERT M. BAERENWALD, DO HEREBY CERTIFY THAT I  
HAVE SURVEYED THE PROPERTY HEREON DESCRIBED ACCORDING  
TO THE OFFICIAL RECORDS AND THAT THE PLAT HEREON IS A  
CORRECT REPRESENTATION OF THE PROPERTY LINES TO THE  
BEST OF MY KNOWLEDGE AND BELIEF.

*Robert M. Baerenwald*  
ROBERT M. BAERENWALD  
WISCONSIN REGISTERED LAND SURVEYOR, S-1508

*April 3, 1987*  
DATE: \_\_\_\_\_ JOB NO. 0948

NOTE: THIS IS NOT A CERTIFIED COPY UNLESS SEALED.

124-154, 157

117-787