



## SYBIL LANE

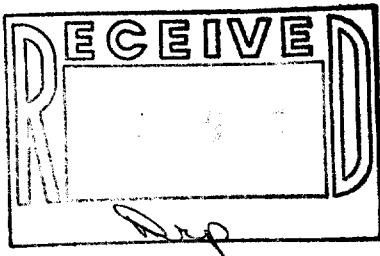

LOT 24 AND THE NORTH 10 FEET OF LOT  
25 OF CAMP SYBIL, A SUBDIVISION  
LOCATED IN SECTION 18, T 1 N, R 17 E,  
WALWORTH COUNTY, WISCONSIN.

ORDERED BY: RANDALL JOHNSON  
C/O KENOSHA SAVINGS & LOAN  
410 BROAD STREET  
LAKE GENEVA, WISCONSIN 53147

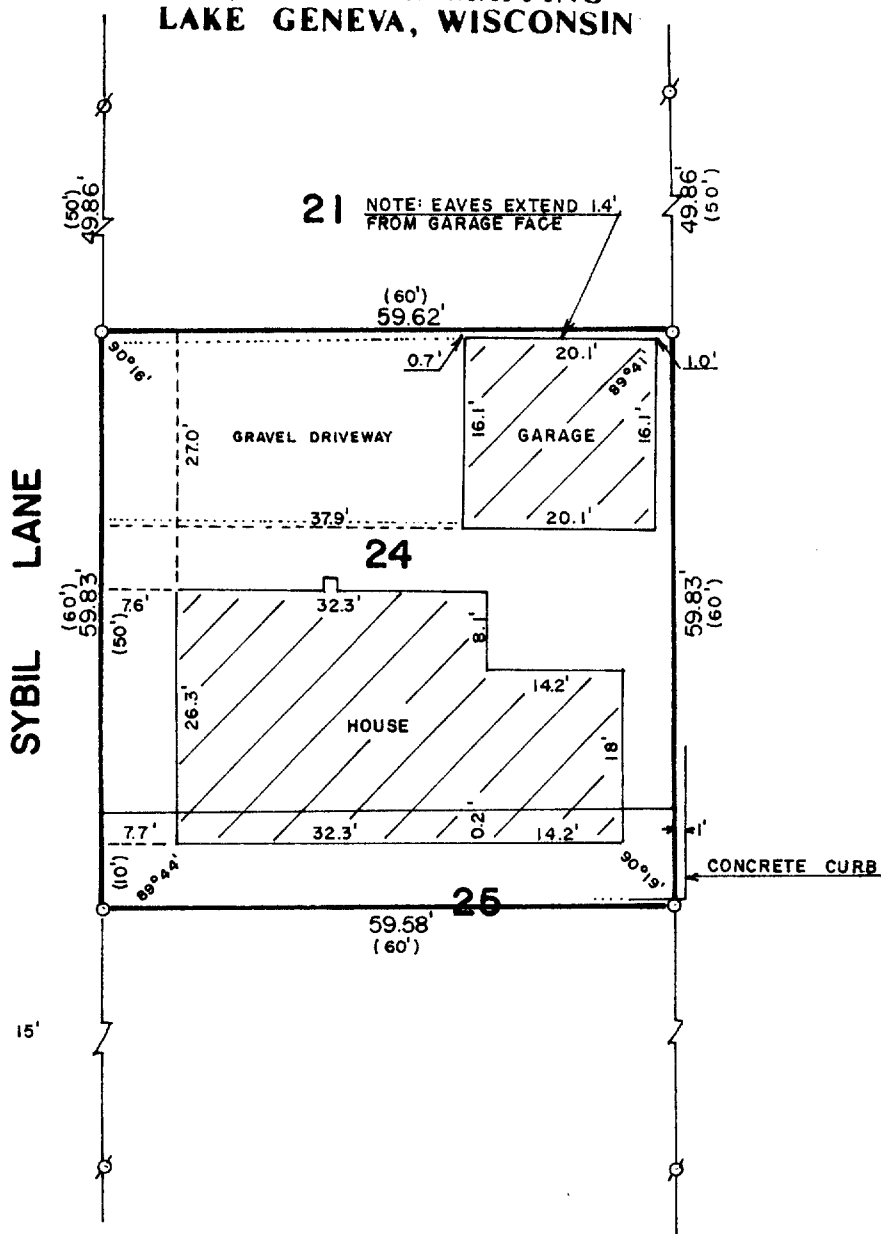

∅ - IRON PIPE FOUND  
 ∅ - IRON ROD FOUND  
 ○ - IRON ROD PLACED  
 ( ) - RECORDED AS

Robert M. Baerenwald  
ROBERT M. BAERENWALD  
WISCONSIN REGISTERED LAND SURVEYOR, S-1508

DATE May 21, 1987 JOB NO. 1047

NOTE: THIS IS NOT A CERTIFIED COPY UNLESS SEALED.