

TEL. 414-723-2098



● = CONCRETE MONUMENT FOUND

(XXXXX) = RECORD DIMENSION



MAP SCALE IN FEET

NOTE: THIS IS A PARTIAL SURVEY OF THE SUBJECT LOT ORDERED BY THE BUILDER FOR THE PURPOSE OF LOCATING THE NEW FOUNDATIONS AS RECENTLY CONSTRUCTED

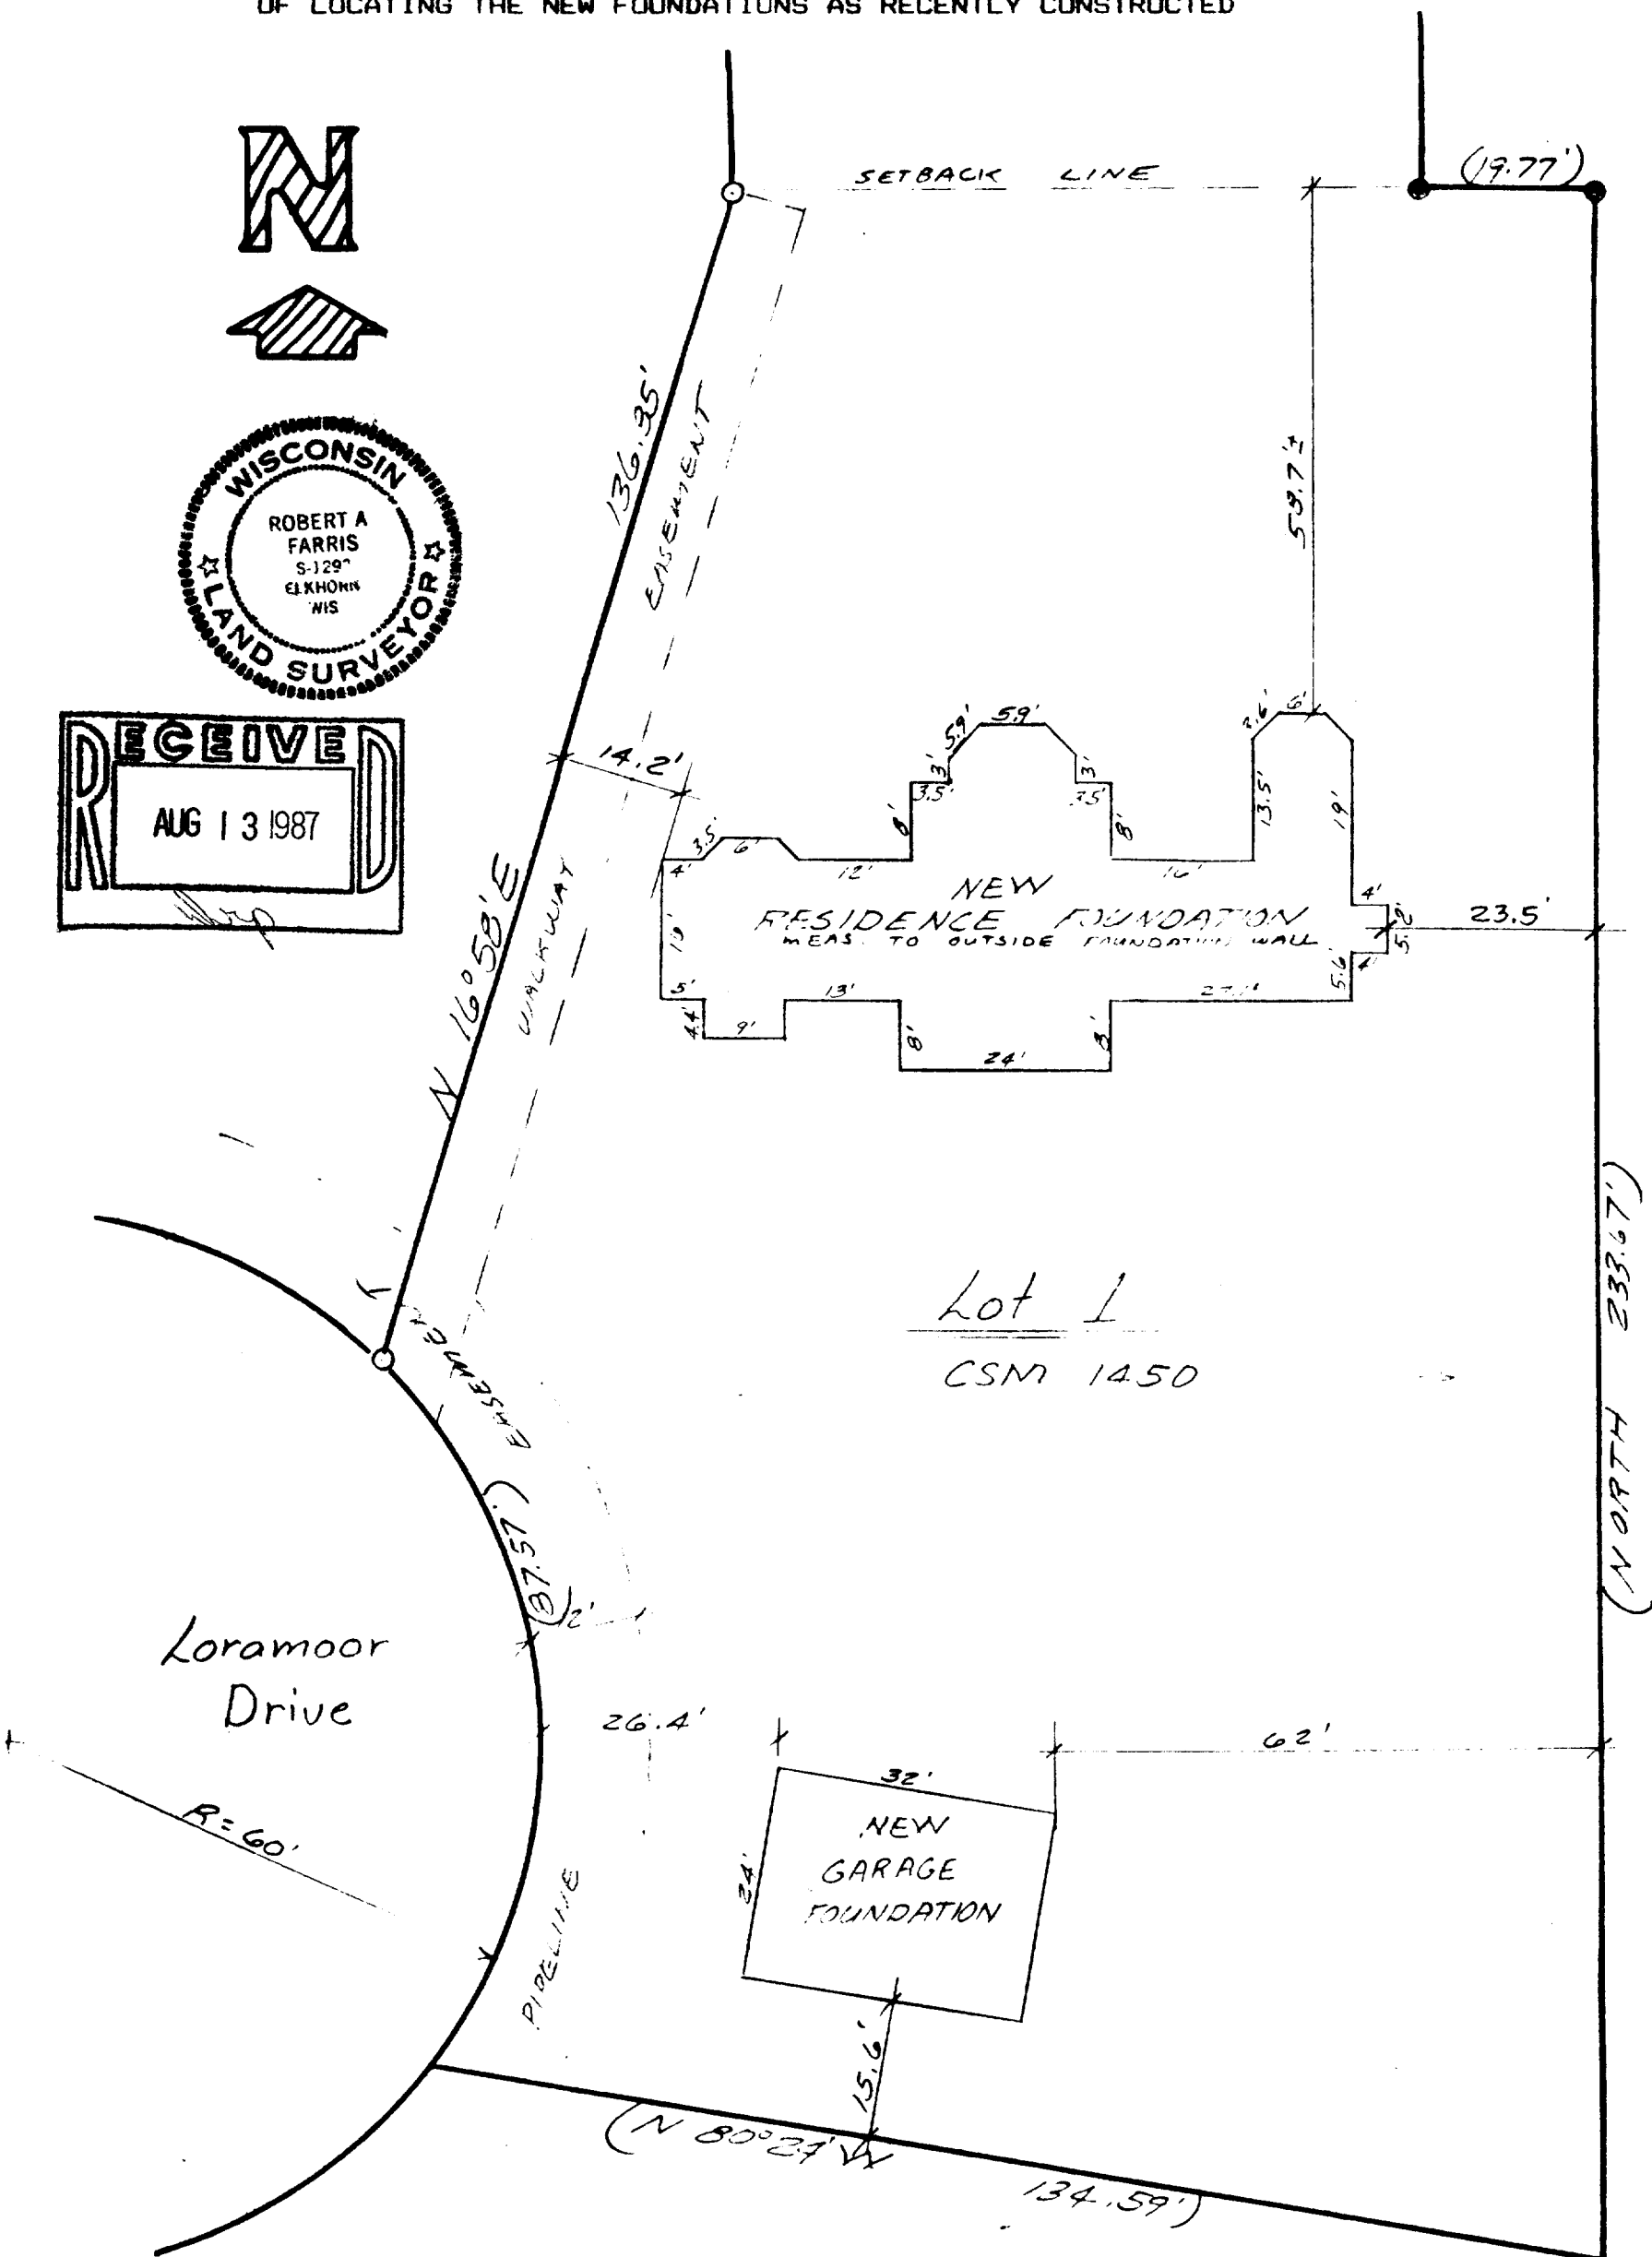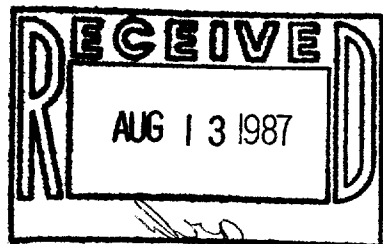

I hereby certify that the above described property has been surveyed under my direction and that the above map is a true representation of the location of the foundation for a building under construction to the best of my professional knowledge and belief.

DATED : JULY 1, 1987

PROJ. NO. 2741

117-796