

Block 1

LOT 8

LOT 7

LOT 6

GREENVIEW DRIVE


SHED

CONCRETE PATIO

HOUSE

Dimensions:

- Lot 8: 129.51' (130')
- Lot 7: 129.44' (130')
- Lot 6: 129.44' (130')
- Greenview Drive: 49.70' (50')
- Shed: 24.8' x 32.0'
- Patio: 24.8' x 32.0'
- House: 24.8' x 32.0'
- Setbacks: 30°04'10", 30°04'40", 30°04'00", 30°04'10"

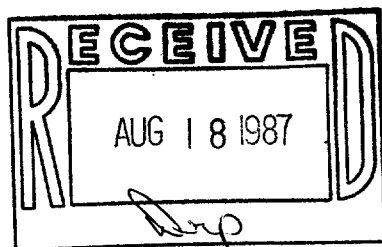

LOT 7, BLOCK 1 OF SUNSET HILLS SUB-
DIVISION, LOCATED IN T 1 N, R 17 E,
WALWORTH COUNTY, WISCONSIN.

ORDERED BY: ASSURED REALTY
P. O. BOX 367
WILLIAMS BAY, WISCONSIN 53191



Ø - IRON PIPE FOUND
 ♂ - IRON PIN FOUND
 () - RECORDED AS

Robert M. Baerenwald
ROBERT M. BAERENWALD
WISCONSIN REGISTERED LAND SURVEYOR, S-1508

DATE June 11, 1987 JOB NO. 1109

NOTE: THIS IS NOT A CERTIFIED COPY UNLESS SEALED.