

KOLB LAND CONSULTING, INC.
 LAND SURVEYING • SUBDIVIDING • LAND PLANNING


929 WILLIAMS STREET LAKE GENEVA, WISCONSIN 53147 414-248-3697

NOTE: BEARINGS ARE ASSUMED AS SHOWN ON RECORDED PLAT.

SCALE: 1" = 60'

LEGEND

- ⊘ - IRON PIPE FOUND
- - CONCRETE MON. FOUND
- () - AS RECORDED
- △ - UTILITY POLE
- - - OVERHEAD UTILITY LINE
- H - HOUSE
- SP - SCREEN PATIO
- G - GARAGE

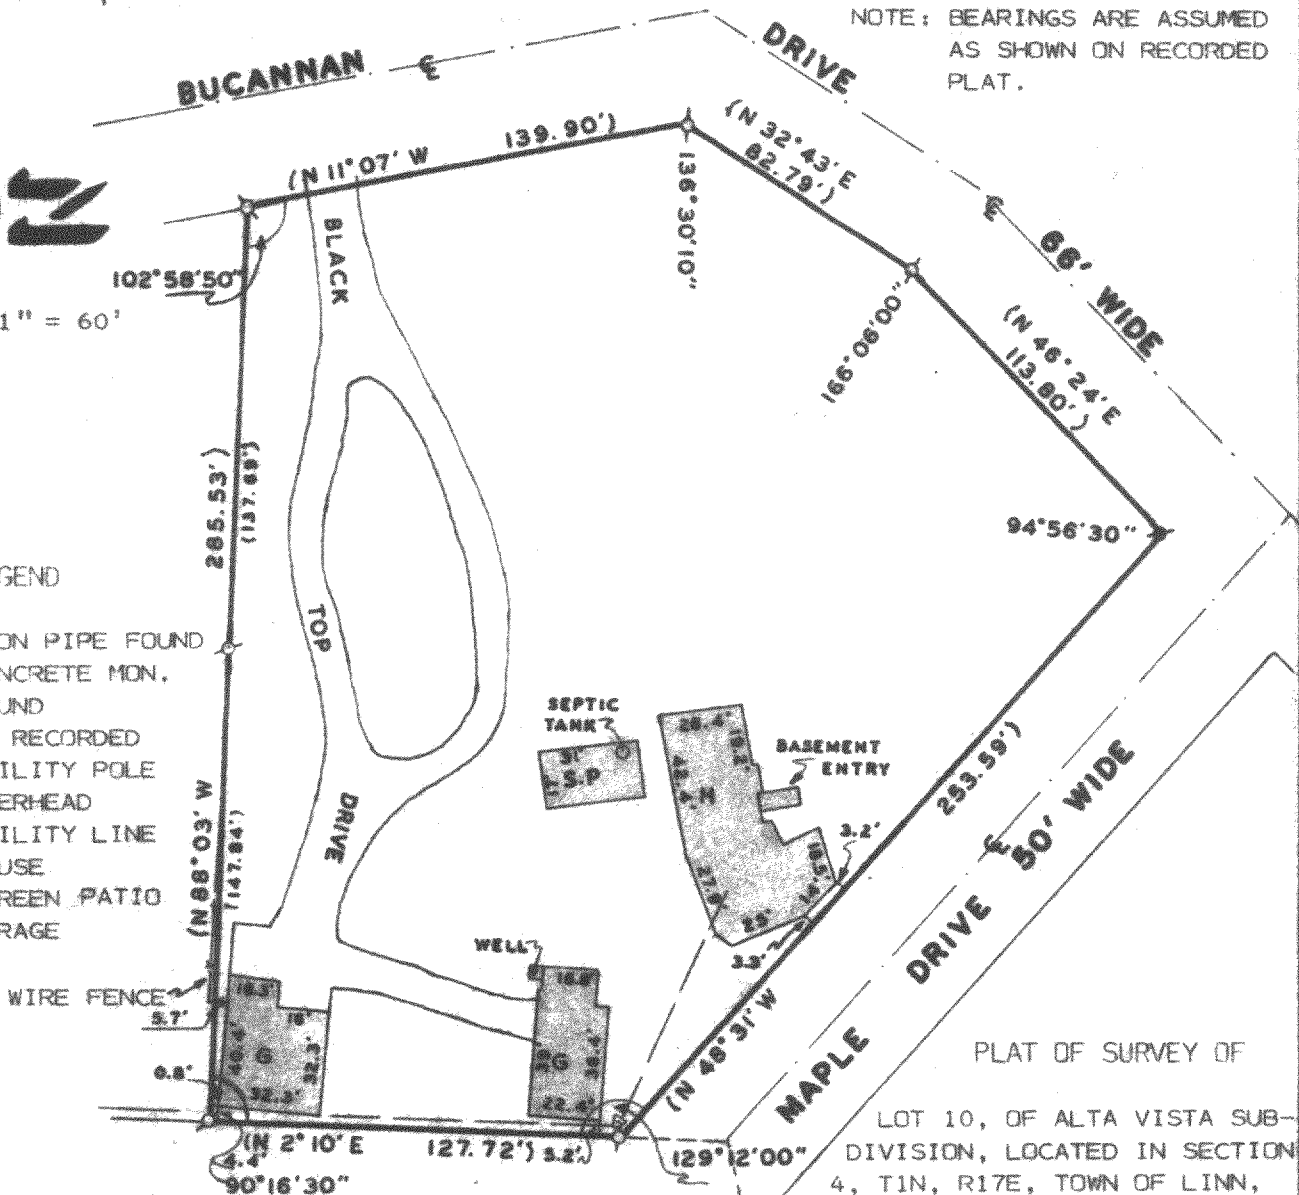


PLAT OF SURVEY OF

LOT 10, OF ALTA VISTA SUB-DIVISION, LOCATED IN SECTION 4, T1N, R17E, TOWN OF LINN, WALWORTH COUNTY, WISCONSIN.

ORDERED BY: GREAT AMERICAN SAVINGS & LOAN
 P.O. BOX 13079
 MILWAUKEE, WI. 53226

NOTE: ANGLES ARE FROM FIELD WORK.

NOTE: FENCE INSIDE PROPERTY LINES EXCEPT AS SHOWN ON PLAT.

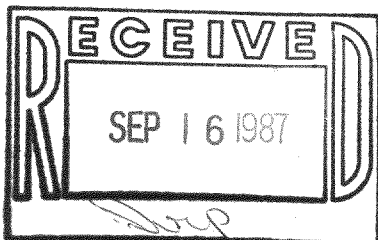

I HEREBY CERTIFY THAT I HAVE SURVEYED THE ABOVE DESCRIBED PROPERTY AND THAT THE ABOVE MAP IS A TRUE REPRESENTATION THEREOF AND SHOWS THE SIZE AND LOCATION OF THE PROPERTY, ITS EXTERIOR BOUNDARIES, THE LOCATION OF ALL VISIBLE STRUCTURES AND DIMENSIONS OF ALL PRINCIPAL BUILDINGS THEREON, BOUNDARY FENCES, APPARENT EASEMENTS, ROADWAYS AND VISIBLE ENCROACHMENTS, IF ANY, TO THE BEST OF MY KNOWLEDGE AND BELIEF.

THIS SURVEY IS MADE FOR THE USE OF THE PRESENT OWNERS OF THE PROPERTY AND ALSO THOSE WHO PURCHASE, MORTGAGE OR GUARANTEE THE TITLE THERETO WITHIN ONE (1) YEAR FROM DATE HEREOF.

NOTE: SURVEY NOT VALID UNLESS SURVEYOR'S SIGNATURE IS IN RED INK.

HAROLD H. KOLB

WISCONSIN REGISTERED LAND SURVEYOR, S- 187

DATE DECEMBER 2, 1986

REVISED _____

REVISED _____