


PROJ. NO. 3000.L14

Farris, Hansen & Associates, Inc.

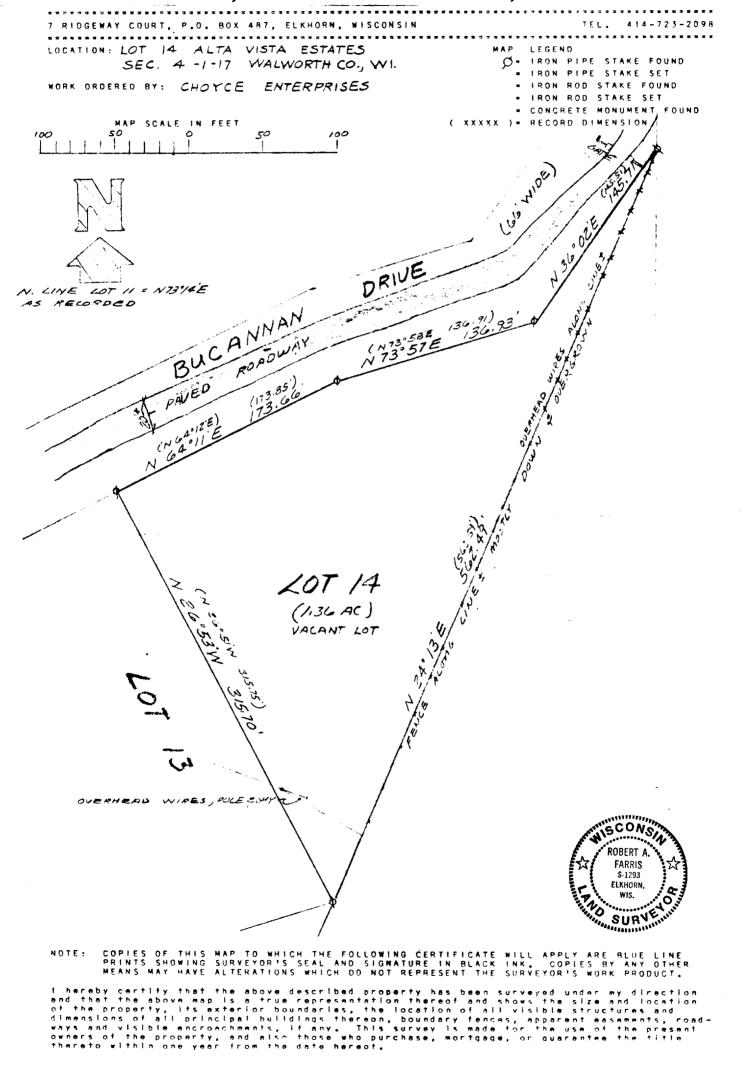

117-899

ELUNAI

DATED : 05/24/88