



WALWORTH COUNTY  
SURVEYING & MAPPING  
LAKE GENEVA, WISCONSIN

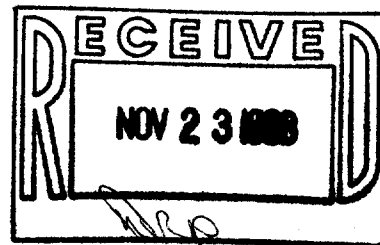

(NORTH STREET)

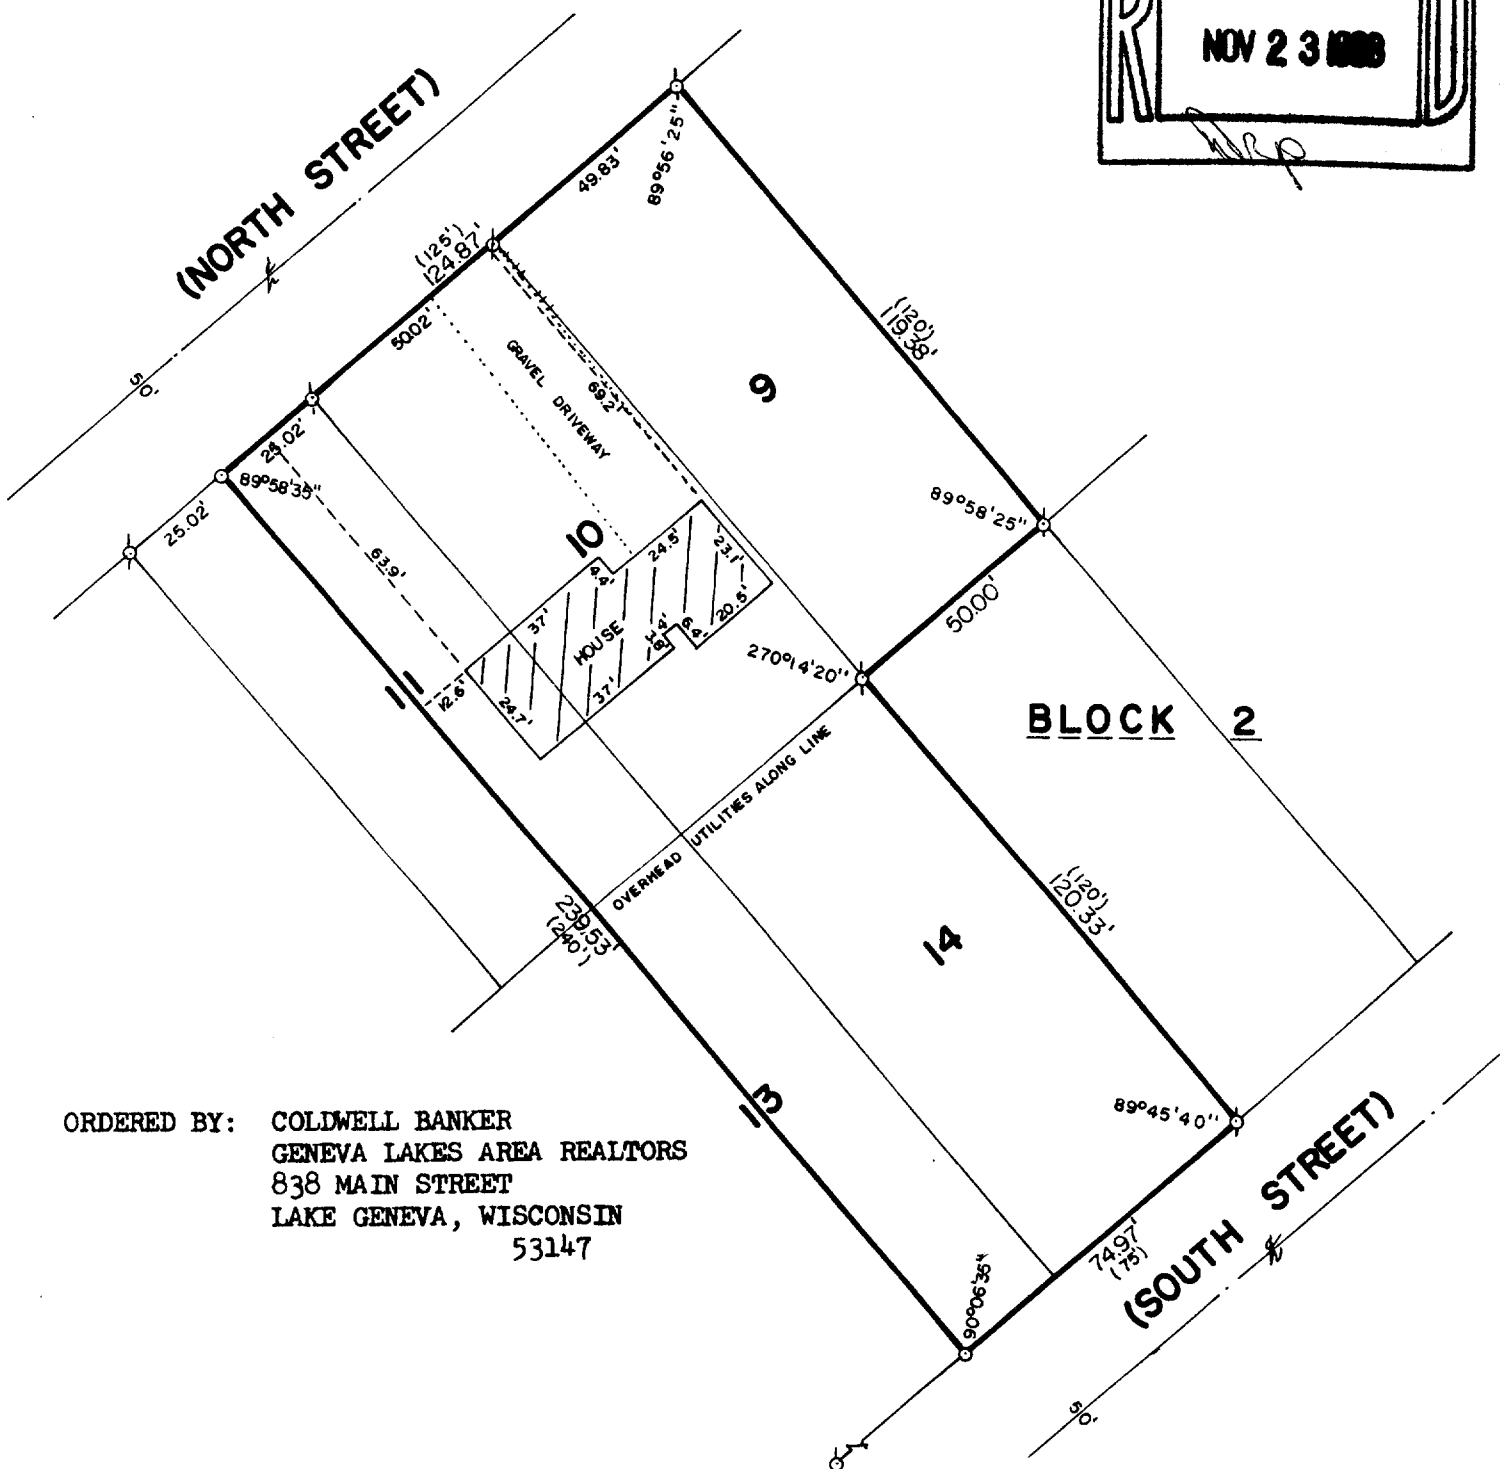

ORDERED BY: COLDWELL BANKER  
GENEVA LAKES AREA REALTORS  
838 MAIN STREET  
LAKE GENEVA, WISCONSIN  
53147

PLAT OF SURVEY OF

LOTS 9, 10, 14 AND THE NORTH 1/2 OF LOTS  
11 AND 13, BLOCK 2 OF ROBINSON HILLSIDE,  
LOCATED IN T 1 N, R 17 E, WALWORTH COUNTY,  
WISCONSIN.

NOTE: THERE ARE NO ENCROACHMENTS.



SCALE: 1"=40'

- ⊘ - IRON PIPE FOUND
- ∅ - IRON ROD FOUND
- - IRON ROD PLACED
- ( ) - RECORDED AS

I, ROBERT M. BAERENWALD, DO HEREBY CERTIFY THAT I  
HAVE SURVEYED THE PROPERTY HEREON DESCRIBED ACCORDING  
TO THE OFFICIAL RECORDS AND THAT THE PLAT HEREON IS A  
CORRECT REPRESENTATION OF THE PROPERTY LINES TO THE  
BEST OF MY KNOWLEDGE AND BELIEF.

*Robert M. Baerenwald*  
ROBERT M. BAERENWALD  
WISCONSIN REGISTERED LAND SURVEYOR, S-1508

*Oct. 10, 1988*  
DATE JOB NO. 1726

NOTE: THIS IS NOT A CERTIFIED COPY UNLESS SEALED.

117-925