
WALWORTH COUNTY SURVEYING & MAPPING LAKE GENEVA, WISCONSIN



PLAT OF SURVEY OF

LOTS 18, 19 AND 20, BLOCK 7 OF SUNSET HILLS, A SUBDIVISION LOCATED IN SECTION 4, T 1 N, R 17 E, WALWORTH COUNTY, WISCONSIN.

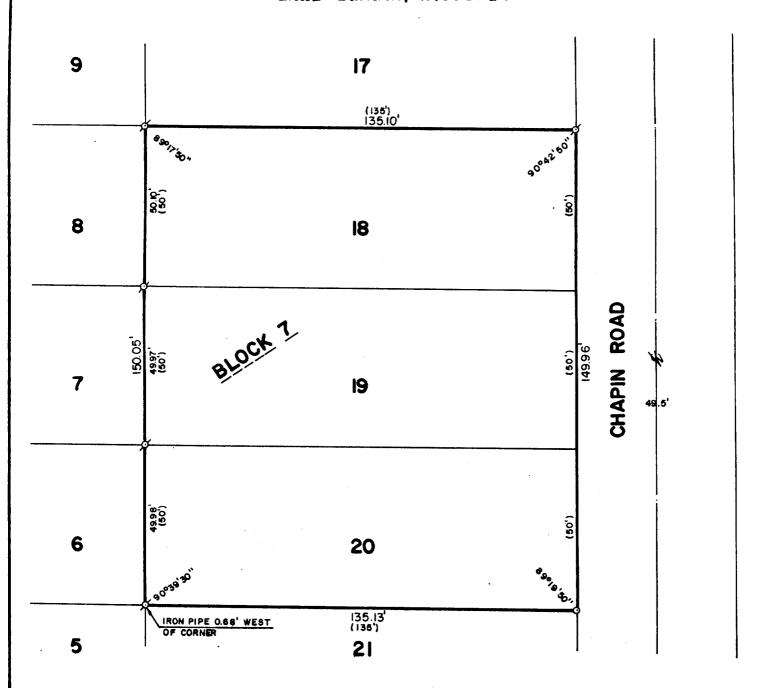

SCALE: 1"=30'

ø-IRON PIPE FOUND
o-IRON PIPE PLACED
()-RECORDED AS

ORDERED BY: KEETE REAL ESTATE
704 MAIN STREET
LAKE GENEVA, WISCONSIN
53147

I HEREBY CERTIFY THAT I HAVE SURVEYED THE ABOVE DESCRIBED PROPERTY AND THAT THE ABOVE MAP IS A TRUE REPRESENTATION THEREOF AND SHOWS THE SIZE AND LOCATION OF THE PROPERTY, ITS EXTERIOR BOUNDARIES, THE LOCATION OF ALL VISIBLE STRUCTURES AND DIMENSIONS OF ALL PRINCIPAL BUILDINGS THEREON, BOUNDARY FENCES, APPARENT EASEMENTS AND ROADWAYS AND VISIBLE ENCROACHMENTS, IF ANY.

THIS SURVEY IS MADE FOR THE EXCLUSIVE USE OF THE PRESENT OWNERS OF THE PROPERTY, AND ALSO THOSE WHO PURCHASE, MORTGAGE, OR GUARANTEE THE TITLE THERETO WITHIN ONE (1) YEAR FROM DATE HEREOF.

ROBERT M. BAERENWALD

WISCONSIN REGISTERED LAND SURVEYOR, S-1508

DATE JOB NO. 1662

NOTE: THIS IS NOT A CERTIFIED COPY UNLESS SEALED.