## KOLB LAND CONSULTING, INC.


LAND SURVEYING . SUBDIVIDING . LAND PLANNING

LAKE GENEVA, WISCONSIN 53147

WHITEWATER, WISCONSIN 53190 RESURVEYED: 5-18-88

SURVEY <u>NOT</u> VALID UNLESS SURVEYOR'S SIGNATURE IS IN RED

HAROLD H. KOLB

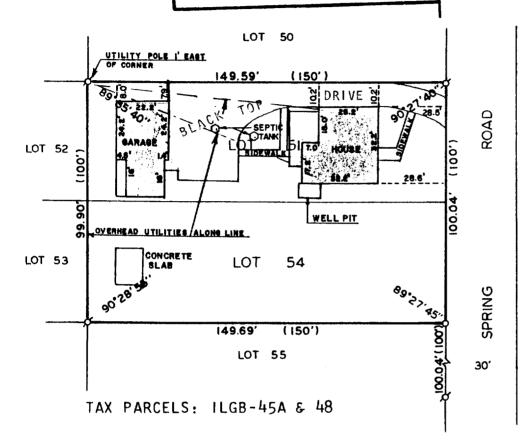

PLAT OF SURVEY OF

LOTS 51 AND 54, LAKE GENEVA BEACH SUB., TOWN 1 NORTH, RANGE 17 EAST, WALWORTH. I C I I V

COUNTY, WISCONSIN.

ORDERED BY:

TERRY WILLIAMS P.O BOX 667 DELAVAN, WI. 53115

FOR OWNER: PAUL G. BARTNICKI

HAROLD H.
POLB
AND THE CONTROL OF TH

SCALE · 1"= 40"

LEGEND

IRON PIPE SET IRON PIPE FOUND Ø

RECORDED AS IRON ROD FOUND ()

I HEREBY CERTIFY THAT I HAVE SURVEYED THE ABOVE DESCRIBED PROPERTY AND THAT THE ABOVE MAP IS A TRUE REPRESENTATION THEREOF AND SHOWS THE SIZE AND LOCATION OF THE PROPERTY, ITS EXTERIOR BOUNDARIES, THE LOCATION OF ALL VISIBLE STRUCTURES AND DIMENSIONS OF ALL PRINCIPAL BUILDINGS THEREON, BOUNDARY FENCES, APPARENT ESSEMENTS, ROADWAYS AND VISIBLE ENEROACHMENTS, IF ANY.

THIS SURVEY IS MADE FOR THE USE OF THE PRESENT OWNERS OF THE PROPERTY, AND ALSO THOSE WHO PURCHASE, MORTGAGE, OR GUARANTEE THE TITLE THERETO WITHIN ONE (1) YEAR FROM DATE HEREOF.

HAROLD H

WISCONSIN REGISTERED LAND SURVEYOR, S-187

1,1982 Septi

SEPTÉMBER 17, 1982 **REVISED:** 

REVISED: APRIL 5. 1984

117-945

MAR | 4 1989